

MAR 17 2000

1999 NOV 22 A 11:09

SECTION

LAND CORNER RECORDATION CERTIFICATE
Filing Requirement of Act 74, Mich. P.A. 1970

NANCY HAVILAND
REGISTER OF DEEDS
LIVINGSTON COUNTY, MI.
48843

For corners in

LIVINGSTON

(County)

Located in: HAMBURG

Corner Code #

9

- 1. Public Land Survey T 1N R 5E G-7
- T R
- T R
- T R
- 2. Property Controlling S T R
- in Section S T R
- 3. Miscellaneous S T R
- Property in Sec. S T R

LSC# 1121m

Register of Deeds Stamp and File Number

- 4. Lot No. _____, Recorded Plat _____
- 5. Private Claims _____

I, Bryan L. Boss, in a field survey on 10-12-99

do hereby certify that under requirements of P.A. 74, Michigan P.A. of 1970, the corner points mentioned in lines 1 and 2 above were in conformance with regulations and rules therefor as required in the current manual of survey instructions of the United States Department of the Interior, Bureau of Land Management or by a decree of a Court of Law and/or that the corner points mentioned in lines 3, 4 and 5 above were in conformance with the rules of the Michigan Board of Land Surveyors or by a Decree of a Court of Law; established, re-established, monumented, re-monumented, recovered, found as expressed below.

NOTE: Not more than 4 corners, all in the same town and range, may be recorded on this certificate.

A. Description of original monument and accessories and/or subsequent restoration:

- SET POST
- TAMARACK 6" N82°W 2L
- TAMARACK 6" S17°E 16L

B. Description of corner evidence found and/or method applied in restoring or reestablishing corner:


FOUND 3/4" IRON PIPE 3' ABOVE GROUND IN SWAMP

C. Description of monument for corner and accessories established to perpetuate locating the position of the corner:

- SET 1 1/4" X 36" PIPE WITH BRASS CAP STAMPED
- "LIVINGSTON COUNTY REMONUMENTATION
- CORNER"
- NORTH 150.76' SET REMON NAIL & TAG E/S 8"
- POPLAR
- N25°W 321.91' SET REMON NAIL & TAG E/S 20"
- OAK
- N50°E 140.43' SET REMON NAIL & TAG E/S 10" OAK
- S75°W 207.32' SET REMON NAIL & TAG N/S 36"
- OAK

A	B	C	D	E	F	G	H	I	J	K	L	M
2	6	5	4	3	2	1						
3												
4	7	8	9	10	11	12						
5												
6	18	17	16	15	14	13						
7												
8	19	20	21	22	23	24						
9												
10	30	29	28	27	26	25						
11												
12	31	32	33	34	35	36						
13												

P.A. 345 1990, APPROVED BY LIVINGSTON COUNTY
PEER GROUP ON 8-18-99 CO. REP JED

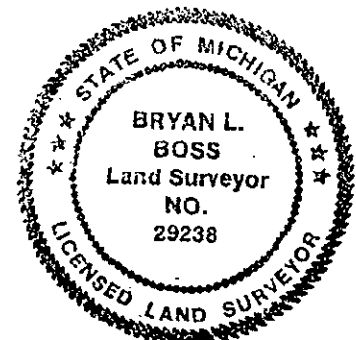

Signed by Bryan L. Boss

Date NOV 10, 1999

Surveyor's Michigan License No. 29238