

SURVEY & REMONUMENTATION

FILED

Nov 16 2 07 PM '94

APR 28 1995 LAND CORNER RECORDATION CERTIFICATE

Filing Requirement of Act 74, Mich. P.A. 1970

NANCY HAVILAND
REGISTER OF DEEDS
LIVINGSTON COUNTY, MI
48843

For corners in
Livingston
(County)

COMMISSION

Located In: Corner Code #/

- | | | | | | |
|------------------------------------|---|-----------|---|-----------|-------------|
| 1. Public Land Survey | T | <u>1N</u> | R | <u>5E</u> | <u>G-11</u> |
| | T | | R | | |
| | T | | R | | |
| | T | | R | | |
| 2. Property Controlling In Section | S | | T | R | |
| | S | | T | R | |
| 3. Miscellaneous Property in Sec. | S | | T | R | |
| | S | | T | R | |

L.S.C.#380m

Register of Deeds Stamp & File Number

4. Lot No. _____, Recorded Plat _____
5. Private Claims _____

A	B	C	D	E	F	G	H	I	J	K	L	M
2	6	5	4	3	2	1						
3												
4	7	8	9	10	11	12						
5												
6	18	17	16	15	14	13						
7												
8	19	20	21	22	23	24						
9												
10	30	29	28	27	26	25						
11												
12	31	32	33	34	35	36						
13												

I, Bryan Boss, in a field survey on 11-2, 19 94, do hereby certify that under requirements of P.A. 74, Michigan P.A. of 1970, the corner points mentioned in lines 1 and 2 above were in conformance with regulations and rules therefore as required in the current manual of survey instructions of the United States Department of the Interior, Bureau of Land Management or by a decree of a Court of Law and/or that the corner points mentioned in lines 3, 4 and 5 above were in conformance with the rules of the Michigan Board of Land Surveyors or by a Decree of a Court of Law; established, re-established, monumented, re-monumented, recovered, found as expressed below:

NOTE: Not more than 4 corners, all in the same town and range, may be recorded on this certificate.

A. Description of original monument and accessories and/or subsequent restoration:

- | | | | |
|----------|-----|---------|----------|
| Tamarack | 4" | East | 24 Links |
| Tamarack | 14" | N 15½ W | 56 Links |
| Tamarack | 6" | N 41½ E | 21 Links |
| Tamarack | 5" | N 63 W | 37 Links |
| Tamarack | 5" | S 15 E | 24 Links |


Additional data on back.

B. Description of corner evidence found and/or method applied in restoring or reestablishing corner:

Found ½" pipe (leaning over) in muck area. Reset by utilizing 2 of 4 witnesses found. No occupation.

C. Description of monument for corner and accessories established to perpetuate locating the position of the corner:
Set 1½" x 36" iron pipe brass cap marked Livingston County Monument Corner.

- N15°E 67.67' N&T E/S 36" Oak
- West 11.96' N&T N/S 4" Willow
- S25°W 51.28' N&T E/S 15" Oak
- East 42.54' Found Concrete Monument

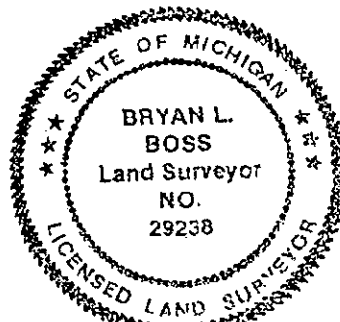

Signed by [Signature]

Date 11-10-1994

Surveyor's Michigan License No. 29238

SUMMARY
G-11

NORTHWEST CORNER, SECTION 34, T1N-R5E HAMBURG TOWNSHIP,
LIVINGSTON COUNTY, MICHIGAN.

Found 1/2" pipe (leaning over) in muck area. Reset by utilizing 2 of 4 witnesses found (see Act 74 page 14 this Dossier). No occupation or fence lines could be found.

No G.L.O. witnesses found (Tamaracks).

On July 1956, Huron Clinton Metropolitan Authority traverse sheet (page 17) calls for approximate location iron pipe at Section corner and witnesses described.

On May 25, 1977, Donald Ross survey (page 12) found 1/2 " iron and witnessed same.

On August 8, 1977, Neree D. Alix platted "Strawberry Hill Estates I" (pages 12, 13). The distance from the Southwest corner of Section 27 to the South 1/4 corner of said Section is 2636.7 feet on G.L.O. notes (page 8 this Dossier); and 2632.22 feet, Neree D. Alix plat (pages 12, 13).

On 10-12-94 Boss Engineering field notes (page 16) finds same 1/2" iron pipe and resets from Act 74 witnesses (page 15).

Conclusion: We recommend accepting 1/2" pipe as found.

HSUMG-11

