

**SURVEY &  
REMONUMENTATION**

FILED

Nov 16 2 07 PM '94

APR 28 1995 LAND CORNER RECORDATION CERTIFICATE  
Filing Requirement of Act 74, Mich. P.A. 1970

NANCY HAVILAND  
REGISTER OF DEEDS  
LIVINGSTON COUNTY, MI  
48843

For corners in Livingston (County) **COMMISSION** Located In: Corner Code #/

1. Public Land Survey	T <u>1N</u> R <u>5E</u>	<u>G-12</u>
	T _____ R _____	_____
	T _____ R _____	_____
	T _____ R _____	_____
2. Property Controlling in Section	S _____ T _____ R _____	_____
	S _____ T _____ R _____	_____
3. Miscellaneous Property in Sec.	S _____ T _____ R _____	_____
	S _____ T _____ R _____	_____

L.S.C. #381m  
Register of Deeds Stamp & File Number

4. Lot No. \_\_\_\_\_, Recorded Plat \_\_\_\_\_  
5. Private Claims \_\_\_\_\_

	A	B	C	D	E	F	G	H	I	J	K	L	M
2	6	5	4	3	2	1							
3													
4	7	8	9	10	11	12							
5													
6	18	17	16	15	14	13							
7													
8	19	20	21	22	23	24							
9													
10	30	29	28	27	26	25							
11													
12	31	32	33	34	35	36							
13													

I, Bryan Boss, in a field survey on 11-2, 19 94, do hereby certify that under requirements of P.A. 74, Michigan P.A. of 1970, the corner points mentioned in lines 1 and 2 above were in conformance with regulations and rules therefore as required in the current manual of survey instructions of the United States Department of the Interior, Bureau of Land Management or by a decree of a Court of Law and/or that the corner points mentioned in lines 3, 4 and 5 above were in conformance with the rules of the Michigan Board of Land Surveyors or by a Decree of a Court of Law; established, re-established, monumented, re-monumented, recovered, found as expressed below:

NOTE: Not more than 4 corners, all in the same town and range, may be recorded on this certificate.

A. Description of original monument and accessories and/or subsequent restoration:

- Black Oak 20" S 8 E 23 Links
- Black Oak 12" N 47 W 21 Links
- Black Oak 10" West 01 07 Links
- Yellow Oak 12" West 2 Links

Additional data on back.


B. Description of corner evidence found and/or method applied in restoring or reestablishing corner:

Found capped iron #19005 Donald Ross. Occupation at fence corner North, South and West. Set by Ross in 1977.

Description of monument for corner and accessories established to perpetuate locating the position of the corner:

at 1 1/2" x 36" iron pipe with brass cap marked Livingston County Monument Corner.

- N50°E 16.75' N&T S/S 8"Cedar
- S40°E 40.49' N&T W/S 42"Oak
- West 21.85' N&T S/S 30"oak
- N20°W 19.69' N&T E/S 4"Hickory

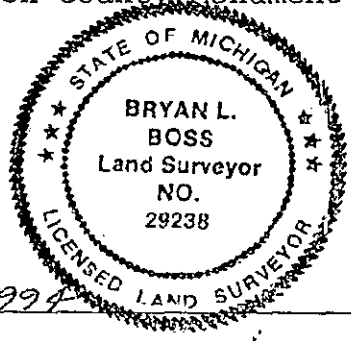

Signed by [Signature] Date 11-10-1994  
Surveyor's Michigan License No. 29238

P.A. 345 1990, APPROVED BY LIVINGSTON COUNTY  
PEER GROUP ON 19 Oct. 94 CO. REP [Signature]

TIN-RSE  
G-12  
Page 1

SUMMARY  
G-12

WEST 1/4 CORNER, SECTION 34, T1N-R5E. HAMBURG TOWNSHIP,  
LIVINGSTON COUNTY, MICHIGAN.

Found Donald W. Ross #19005 capped iron at corner of fences running North, South and West. Over hanging branches will make this corner difficult for G.P.S.

The Township lines were originally surveyed by Joseph Wampler in 1823. West 1/4 Corner of Section 34 was witnessed again in 1905 by Miles W. Bullock and again in 1907 by Grant Dunning.


On 28 April 1967, Charles Garlock surveyed East & West 1/4 line Westerly to centerline of Strawberry Lake Road (Note Grant Dunning's witness on page 9). ON May 25, 1977, Donald Ross Survey (page 10) set iron & cap at SE corner of fence post and witnesses same.

On 8-21-92 (page 13) Boss Engineering surveyed Southeast 1/4 of Section 33 for "Strawberry Woods" site condominiums.

On 5-9-94 Boss Engineering found 2 of 4 Donald Ross witness trees. The 28" red oak is now 30" and 0.11 short. The 4" cedar is now 8" and is 0.13 short of measured distance.

Conclusion: We find the capped iron set by Donald Ross in 1977 is in the same location as on 5-9-94 and recommend its acceptance as found.

HSUMG-12

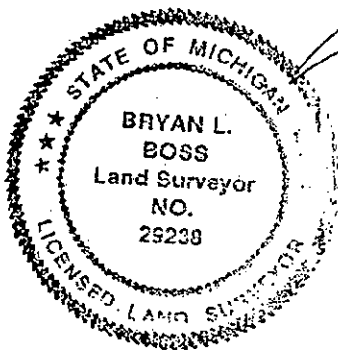

*Bryan L. Boss*