

MAR 17 2000

FILED

SECTION

LAND CORNER RECORDATION CERTIFICATE
Filing Requirement of Act 74, Mich. P.A. 1970

1999 NOV 22 A 11:09

For corners in

LIVINGSTON

(County)

Located in: HAMBURG Corner Code #

9

NANCY HAVILAND
REGISTER OF DEEDS
LIVINGSTON COUNTY, MI.
48843

- 1. Public Land Survey T 1N R 5E H-9
T R
T R
T R
- 2. Property Controlling S T R
in Section S T R
- 3. Miscellaneous S T R
Property in Sec. S T R

LSC# 1127m

Register of Deeds Stamp and File Number

- 4. Lot No. _____, Recorded Plat _____
- 5. Private Claims _____

I, Bryan L. Boss, in a field survey on 10-28-99

do hereby certify that under requirements of P.A. 74, Michigan P.A. of 1970, the corner points mentioned in lines 1 and 2 above were in conformance with regulations and rules therefor as required in the current manual of survey instructions of the United States Department of the Interior, Bureau of Land Management or by a decree of a Court of Law and/or that the corner points mentioned in lines 3,4 and 5 above were in conformance with the rules of the Michigan Board of Land Surveyors or by a Decree of a Court of Law; established, re-established, monumented, re-monumented, recovered, found as expressed below.

NOTE: Not more than 4 corners, all in the same town and range, may be recorded on this certificate.

A	B	C	D	E	F	G	H	I	J	K	L	M
2	6	5	4	3	2	1						
3												
4	7	8	9	10	11	12						
5												
6	18	17	16	15	14	13						
7												
8	19	20	21	22	23	24						
9												
10	30	29	28	27	26	25						
11												
12	31	32	33	34	35	36						
13												

A. Description of original monument and accessories and/or subsequent restoration:

SET POST
12" ASH N77°E 3L
6" ELM S06°E 27L

B. Description of corner evidence found and/or method applied in restoring or reestablishing corner:


FOUND 1" PIPE IN CENTERLINE PETTYS ROAD
REMOVED PIPE AND FOUND 1/2" IRON ROD INSIDE PIPE
FOUND CONCRETE MONUMENT (PIPE IN CONCRETE) 1.5' BELOW
ROAD SURFACE AT CORNER LOCATION. LEFT MONUMENT IN
PLACE AND PLACED 1 1/4"X12" PIPE OVER MONUMENT.

C. Description of monument for corner and accessories established to perpetuate locating the position of the corner:

SET 1 1/4" X 12" PIPE WITH BRASS CAP
STAMPED "LIVINGSTON COUNTY
REMONUMENTATION CORNER" ABOVE A
CONCRETE MONUMENT LYING 1.5 FEET BELOW
ROAD SURFACE INSIDE A MONUMENT BOX.
N45°E 37.73' SET REMON NAIL & TAG NW/S
TRIPLE 6" MAPLE N70°W 28.04' SET REMON NAIL & TAG E/S 10" ASH
S30°W 52.36' SET REMON NAIL & TAG W/S
TRIPLE 4" MAPLE
S30°E 57.78' SET REMON NAIL & TAG E/S 14"
MAPLE

PA. 345 1990, APPROVED BY LIVINGSTON COUNTY

8-4-99 CO. REP JED

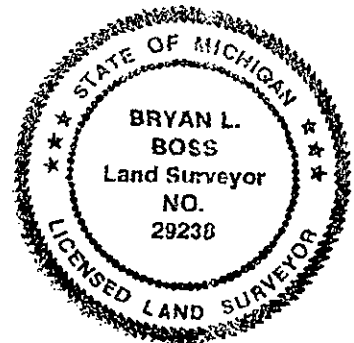

Signed by [Signature]

Date NOV. 9, 1999

Surveyor's Michigan License No. 29238