

MAR 17 2000

SECTION

LAND CORNER RECORDATION CERTIFICATE  
Filing Requirement of Act 74, Mich. P.A. 1970

FILED

1999 NOV 22 A 11: 09

For corners in  
LIVINGSTON  
(County)

Located in: HAMBURG Corner Code #

9

NANCY HAVILAND  
REGISTER OF DEEDS  
LIVINGSTON COUNTY, MI.  
48843

- 1. Public Land Survey T IN R 5E I-4
- T R
- T R
- T R
- 2. Property Controlling S T R
- in Section S T R
- 3. Miscellaneous S T R
- Property in Sec. S T R

ISC# 1128m

Register of Deeds Stamp and File Number

- 4. Lot No. \_\_\_\_\_, Recorded Plat \_\_\_\_\_
- 5. Private Claims \_\_\_\_\_

I, Bryan L. Boss, in a field survey on 10-19-99, do hereby certify that under requirements of P.A. 74, Michigan P.A. of 1970, the corner points mentioned in lines 1 and 2 above were in conformance with regulations and rules therefor as required in the current manual of survey instructions of the United States Department of the Interior, Bureau of Land Management or by a decree of a Court of Law and/or that the corner points mentioned in lines 3, 4 and 5 above were in conformance with the rules of the Michigan Board of Land Surveyors or by a Decree of a Court of Law; established, re-established, monumented, re-monumented, recovered, found as expressed below.

NOTE: Not more than 4 corners, all in the same town and range, may be recorded on this certificate.

A. Description of original monument and accessories and/or subsequent restoration:

- SET POST
- 15" BLACK OAK S37 1/2"W 23 LINKS
- 12" BLACK OAK N02°E 72 LINKS

B. Description of corner evidence found and/or method applied in restoring or reestablishing corner:


FOUND 3/4" IRON PIPE WITH CAP #12029 ON EAST-WEST FENCE

C. Description of monument for corner and accessories established to perpetuate locating the position of the corner:

- SET 1 1/4" X 36" PIPE WITH BRASS CAP STAMPED "LIVINGSTON COUNTY REMONUMENTATION CORNER".
- DUE NORTH 15.70' SET REMON NAIL & TAG E/S 10" OAK
- DUE WEST 24.00' SET REMON NAIL & TAG S/S 20" OAK
- DUE SOUTH 24.33' SET REMON NAIL & TAG W/S 14" OAK
- DUE EAST 32.07' SET REMON NAIL & TAG S/S 16" OAK

A	B	C	D	E	F	G	H	I	J	K	L	M
2	6	5	4	3	2	1						
3												
4	7	6	9	10	11	12						
5												
6	18	17	16	15	14	13						
7												
8	19	20	21	22	23	24						
9												
10	30	29	28	27	26	25						
11												
12	31	32	33	34	35	36						
13												

P.A. 345 1990, APPROVED BY LIVINGSTON COUNTY  
PEER GROUP ON 7-21-99 CO. REP JED

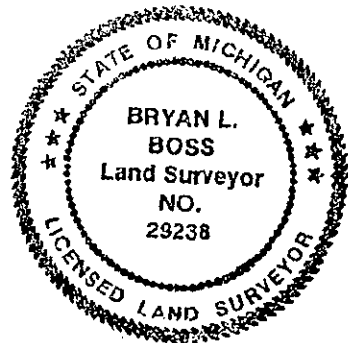

Signed by Bryan L. Boss Date NOV 9, 1999  
Surveyor's Michigan License No. 29238