

FEB 25 1999

SECTION

LAND CORNER RECORDATION CERTIFICATE

Filing Requirement of Act 74, Mich. P.A. 1970

1998 OCT 27 P 2: 22

For corners in

Livingston (County)

Located in:

Corner Code //

- 1. Public Land Survey T 1N R 5E I-8
- T R
- T R
- T R
- 2. Property Controlling S T R
- in Section S T R
- 3. Miscellaneous S T R
- Property in Sec. S T R

NANCY HAVILAND REGISTER OF DEEDS LIVINGSTON COUNTY, MI. 48843

LSC962M

Register of Deeds Stamp & File Number

- 4. Lot No. , Recorded Plat
- 5. Private Claims

	A	B	C	D	E	F	G	H	I	J	K	L	M
2	6	5	4	3	2								
3													
4	7	8	9	10	11	12							
5													
6	16	17	16	15	14	13							
7													
8	19	20	21	22	23	24							
9													
10	30	29	28	27	26	25							
11													
12	31	32	33	34	35	36							
13													

I, Bryan L. Boss, in a field survey on Oct. 2, 1998, do hereby certify that under requirements of P.A. 74, Michigan P.A. of 1970, the corner points mentioned in lines 1 and 2 above were in conformance with regulations and rules therefore as required in the current manual of survey instructions of the United States Department of the Interior, Bureau of Land Management or by a decree of a Court of Law and/or that the corner points mentioned in lines 3, 4 and 5 above were in conformance with the rules of the Michigan Board of Land Surveyors or by a Decree of a Court of Law; established, re-established, monumented, re-monumented, recovered, found as expressed below:

NOTE: Not more than 4 corners, all in the same town and range, may be recorded on this certificate.

A. Description of original monument and accessories and/or subsequent restoration:

Set post 1823 White Oak 12" S 78 W 25 L Black Oak 12" N 4 E 31 L


B. Description of corner evidence found and/or method applied in restoring or reestablishing corner:

Found 1/2" iron rod in monument box

PA. 345 1890, APPROVED BY LIVINGSTON COUNTY PEER GROUP ON 9-2-98 CO. REP JED

C. Description of monument for corner and accessories established to perpetuate locating the position of the corner:

Set 1 1/4' by 30" long pipe W/breakaway 1 1/4" by 6" pipe & Brass cap Stamped "Livingston County Monumentation Corner" in existing Monument Box N 40 E Remon N/T NW/S 18" Oak 38.66' S 85 E Remon N/T S/S 10" Poplar 23.09' S 07 W Remon N/T E/S 12" Twin Elm 102.01' N 85 W Remon N/T N/S Guard Rail Post 67.08'

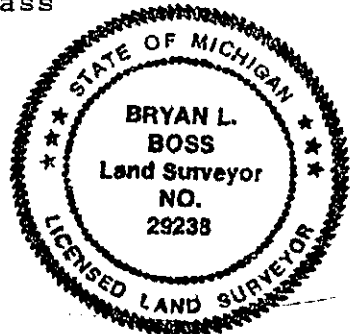

Signed by [Signature] Surveyor's Michigan License No. 29238

Date 10-15-1998