

SURVEY & REMONUMENTATION

FEB 25 1999

FILED

9

SECTION

LAND CORNER RECORDATION CERTIFICATE

Filing Requirement of Act 74, Mich. P.A. 1970

1998 OCT 27 P 2: 22

For corners in

Livingston County

Located In:

Corner Code //

NANCY HAVILAND  
REGISTER OF DEEDS  
LIVINGSTON COUNTY, MI.  
48843

LSC965M

Register of Deeds Stamp & File Number

1. Public Land Survey	T	<u>1N</u>	<u>R5E</u>	<u>J-5</u>
	I	---	R	---
	T	---	R	---
	T	---	R	---
2. Property Controlling in Section	S	---	T	---
	S	---	T	---
3. Miscellaneous Property in Sec.	S	---	T	---
	S	---	T	---

- 4. Lot No. \_\_\_\_\_, Recorded Plat \_\_\_\_\_
- 5. Private Claims \_\_\_\_\_

A	B	C	D	E	F	G	H	I	J	K	L	M
2	6	5	4	3	2	1						
3												
4	7	8	9	10	11	12						
5												
6	16	17	18	15	14	13						
7												
8	19	20	21	22	23	24						
9												
10	30	29	28	27	26	25						
11												
12	31	32	33	34	35	36						
13												

I, Bryan L. Boss, in a field survey on October 6, 1998, do hereby certify that under requirements of P.A. 74, Michigan P.A. of 1970, the corner points mentioned in lines 1 and 2 above were in conformance with regulations and rules therofore as required in the current manual of survey instructions of the United States Department of the Interior, Bureau of Land Management or by a decree of a Court of Law and/or that the corner points mentioned in lines 3, 4 and 5 above were in conformance with the rules of the Michigan Board of Land Surveyors or by a Decree of a Court of Law; established, re-established, monumented, re-monumented, recovered, found as expressed below:

NOTE: Not more than 4 corners, all in the same town and range, may be recorded on this certificate.

A. Description of original monument and accessories and/or subsequent restoration:

Set post 1823 by Wampler


B. Description of corner evidence found and/or method applied in restoring or reestablishing corner:

Found 1/2" iron pipe at North side of fence corner post

PA. 345 1990, APPROVED BY LIVINGSTON COUNTY  
PEER GROUP ON 9-30-98, CO. REP JED

C. Description of monument for corner and accessories established to perpetuate localing the position of the corner:

Set 1 1/4" by 36" iron pipe with Brass Cap Stamped " Livingston County Monumentation Corner  
N 20 W 31.56' set Remon N/T NE/S 30" Oak  
N 15 E 43.36' set Remon N/T W/S 22" Cherry  
S 60 E 27.23 set Remon N/T S/S 15" Cherry  
S 60 W 16.10' set Remon N/T S/S 15" Oak  
S 70° E 1.34' Fd. 3/4" I.P.

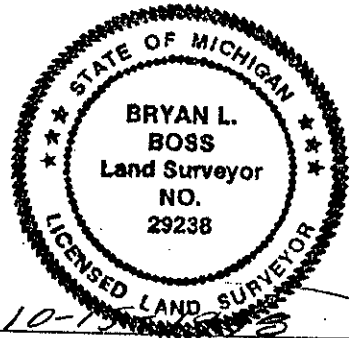

Signed by Bryan L. Boss  
Surveyor's Michigan License No. 29238

Date 10-15-98