

FEB 25 1999

SECTION

LAND CORNER RECORDATION CERTIFICATE
Filing Requirement of Act 74, Mich. P.A. 1970

1998 OCT 27 P 2:22

9- FILED

For corners in

Livingston Located In: Corner Code //

1. Public Land Survey T 1N R 5E J-9

2. Property Controlling in Section S T R

3. Miscellaneous Property in Sec. S T R

4. Lot No. _____, Recorded Plat _____

5. Private Claims _____

NANCY HAVILAND
REGISTER OF DEEDS
LIVINGSTON COUNTY, MI.
48843

LSC967M

Register of Deeds Stamp & File Number

Bryan L. Boss in a field survey on October 2, 1998
I hereby certify that under requirements of P.A. 74, Michigan P.A. of 1970, the corner points mentioned in lines 1 and 2 above were in conformance with regulations and rules therefore as required in the current manual of survey instructions of the United States Department of the Interior, Bureau of Land Management or by a decree of a Court of Law and/or that the corner points mentioned in lines 3, 4 and 5 above were in conformance with the rules of the Michigan Board of Land Surveyors or by a Decree of a Court of Law; established, re-established, monumented, re-monumented, recovered, found as expressed below:

NOTE: Not more than 4 corners, all in the same town and range, may be recorded on this certificate.

	A	B	C	D	E	F	G	H	I	J	K	L	M
2	6	5	4	3	2	1							
3													
4	7	8	9	10	11	12							
5													
6	13	17	16	15	14	13							
7													
8	19	20	21	22	23	24							
9													
10	30	29	28	27	26	25							
11													
12	31	32	33	34	35	36							
13													

A. Description of original monument and accessories and/or subsequent restoration:

Corner established in 1823 by Wampler at average distance in lake no witnesses


B. Description of corner evidence found and/or method applied in restoring or reestablishing corner:

Found 5/8" iron rod in monument Box

P.A. 345 1990, APPROVED BY LIVINGSTON COUNTY
PEER GROUP ON 9-30-98 CO. REP JED

C. Description of monument for corner and accessories established to perpetuate locating the position of the corner:

Set 1 1/2" by 30" iron pipe with plastic break away & 1 1/2" by 6" iron pipe with Brass cap stamped "Livingston County monumentation Corner"
S 05 W 28.96' found 1/2" rod and cap # 17022
N 03 W 43.22 set Remon N/T in top of guard rail post
S 34 E 35.26 set Remon N/T NE/S 18" Elm
S 53 W 64.24 set Remon N/t NW/S 28" poplar
West 97.69 set Remon N/T N/S P.Pole

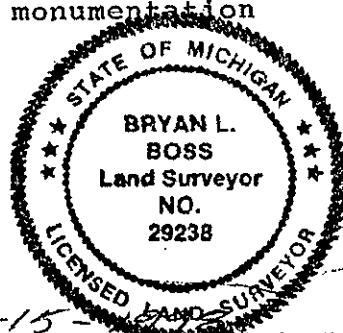

Signed by Bryan L. Boss Date 10-15-98
Surveyor's Michigan License No. 29238