

FILED

DEC 29 11 26 AM '93

LAND CORNER RECORDATION CERTIFICATE
Filing Requirement of Act 74, Mich. P.A. 1970

NANCY HAVILAND
REGISTER OF DEEDS
LIVINGSTON COUNTY, MI
48843

For corners in

Livingston Located In: Corner Code #
(County)

1. Public Land Survey T 1N R 5E J-11
T _____ R _____
T _____ R _____
T _____ R _____

2. Property Controlling S _____ T _____ R _____
in Section S _____ T _____ R _____

3. Miscellaneous S _____ T _____ R _____
Property in Sec. S _____ T _____ R _____

L.S.C. #187m
Register of Deeds Stamp & File Number

4. Lot No. _____, Recorded Plat _____
5. Private Claims _____

	A	B	C	D	E	F	G	H	I	J	K	L	M
2	6		5		4		3		2		1		
3													
4	7		8		9		10		11		12		
5													
6	18		17		16		15		14		13		
7													
8	19		20		21		22		23		24		
9													
10	30		29		28		27		26		25		
11													
12	31		32		33		34		35		36		
13													

I, Bryan Boss, in a field survey on December 21, 1993, do hereby certify that under requirements of P.A. 74, Michigan P.A. of 1970, the corner points mentioned in lines 1 and 2 above were in conformance with regulations and rules therefore as required in the current manual of survey instructions of the United States Department of the Interior, Bureau of Land Management or by a decree of a Court of Law and/or that the corner points mentioned in lines 3, 4 and 5 above were in conformance with the rules of the Michigan Board of Land Surveyors or by a Decree of a Court of Law; established, re-established, monumented, re-monumented, recovered, found as expressed below:

NOTE: Not more than 4 corners, all in the same town and range, may be recorded on this certificate.

A. Description of original monument and accessories and/or subsequent restoration:

- B. Oak 24 in. Dia. S57 1/2°W 105 Lks.
- W. Oak 26 in. Dia. N57E 49 Lks.

B. Description of corner evidence found and/or method applied in restoring or reestablishing corner:

1/2" Iron in Concrete


SURVEY &
RE MONUMENTATION
1993
COMMISSION

C. Description of monument for corner and accessories established to perpetuate locating the position of the corner:

- Set 1 1/4" x 36" Iron Pipe with Brass Cap (Livingston Co. Monument Corner)
- West 47.05' Spike S/Side 8" Hickory
- N45°E 2.50' Spike 30" Oak
- S60°E 27.78' Spike S/Side 20" Oak
- S05°E 21.66' Spike W/Side 15" Oak

Approved by Livingston Co. Monumentation Peer Group on September 8, 1993

Signed by _____
Surveyor's Michigan License No. 29238

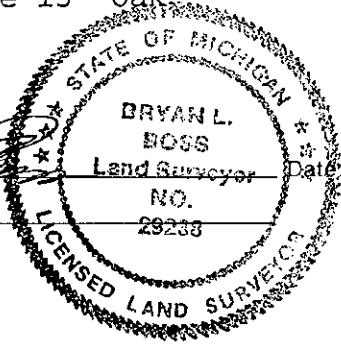

December 28, 1993