

SURVEY & REMONUMENTATION

OCT 21 1999

LAND CORNER RECORDATION CERTIFICATE
 Filing Requirement of Act 74, Mich. P.A. 1970

DEC 29 11 26 AM '93

NANCY HAVILAND
 REGISTER OF DEEDS
 LIVINGSTON COUNTY, MI
 48843

SECTION

For corners in

<u>Livingston</u> (County)	Located In:	Corner Code #/
1. Public Land Survey	T <u>1N</u> R <u>5E</u>	<u>J-12</u>
	T _____ R _____	
	T _____ R _____	<u>Seq. #1 pm</u>
	T _____ R _____	
2. Property Controlling in Section	S _____ T _____ R _____	
	S _____ T _____ R _____	
3. Miscellaneous Property in Sec.	S _____ T _____ R _____	
	S _____ T _____ R _____	
4. Lot No. _____, Recorded Plat _____		
5. Private Claims _____		

L.S.C. #189m

Register of Deeds Stamp & File Number

I, Bryan Boss, in a field survey on December 21, 1993, do hereby certify that under requirements of P.A. 74, Michigan P.A. of 1970, the corner points mentioned in lines 1 and 2 above were in conformance with regulations and rules therefore as required in the current manual of survey instructions of the United States Department of the Interior, Bureau of Land Management or by a decree of a Court of Law and/or that the corner points mentioned in lines 3, 4 and 5 above were in conformance with the rules of the Michigan Board of Land Surveyors or by a Decree of a Court of Law; established, re-established, monumented, re-monumented, recovered, found as expressed below:

A	B	C	D	E	F	G	H	I	J	K	L	M
2	6	5	4	3	2	1						
3												
4	7	8	9	10	11	12						
5												
6	18	17	16	15	14	13						
7												
8	19	20	21	22	23	24						
9												
10	30	29	28	27	26	25						
11												
12	31	32	33	34	35	36						
13												

NOTE: Not more than 4 corners, all in the same town and range, may be recorded on this certificate.

A. Description of original monument and accessories and/or subsequent restoration:

Not a Government Corner

B. Description of corner evidence found and/or method applied in restoring or reestablishing corner:

Found 1/2" Rebar at Occupied Fence Intersection
 Theoretical Center of Section is N 51°19'05" E, 7.18 Feet


C. Description of monument for corner and accessories established to perpetuate locating the position of the corner:

Set 1 1/4" x 36" Iron Pipe with Brass Cap
 (Livingston Co. Monument Corner)

North 20.26' Spike 15" Cherry
 N85°E 37.34' Spike 8" Cherry
 South 3.00' Spike 10" Walnut
 S85°W 34.97' Spike 12" Walnut

Approved by Livingston Co.
 Monumentation Peer Group
 on September 15, 1993

Signed by [Signature]
 Surveyor's Michigan License No. 29238

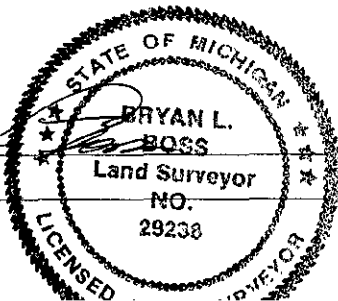

Date December 28, 1993