

FILED

9/2

JUN 14 8 32 AM '94

LAND CORNER RECORDATION CERTIFICATE
Filing Requirement of Act 74, Mich. P.A. 1970

NANCY HAVILAND
REGISTER OF DEEDS
LIVINGSTON COUNTY, MI
48643

For corners in
Livingston
(County)

	Located In:		Corner Code ##
	1N	5E	
1. Public Land Survey	T _____	R _____	J-12
	T _____	R _____	
	T _____	R _____	
	T _____	R _____	
2. Property Controlling in Section	S _____	T _____	R _____
	S _____	T _____	R _____
3. Miscellaneous Property in Sec.	S _____	T _____	R _____
	S _____	T _____	R _____

L.S.C.#193m
Register of Deeds Stamp & File Number

4. Lot No. _____, Recorded Plat _____
5. Private Claims _____

Bryan Boss December 21 93


I, _____, in a field survey on _____, 19 _____, do hereby certify that under requirements of P.A. 74, Michigan P.A. of 1970, the corner points mentioned in lines 1 and 2 above were in conformance with regulations and rules therefore as required in the current manual of survey instructions of the United States Department of the Interior, Bureau of Land Management or by a decree of a Court of Law and/or that the corner points mentioned in lines 3, 4 and 5 above were in conformance with the rules of the Michigan Board of Land Surveyors or by a Decree of a Court of Law, established, re-established, monumented, re-monumented, recovered, found as expressed below:

	A	B	C	D	E	F	G	H	I	J	K	L	M
2	6		5		4		3		2		1		
3													
4	7		8		9		10		11		12		
5													
6	18		17		16		15		14		13		
7													
8	19		20		21		22		23		24		
9													
10	30		29		28		27		26		25		
11													
12	31		32		33		34		35		36		
13													

NOTE: Not more than 4 corners, all in the same town and range, may be recorded on this certificate.

A. Description of original monument and accessories and/or subsequent restoration:
Not a Government Corner
Additional information on back.

B. Description of corner evidence found and/or method applied in restoring or reestablishing corner:
Found 1/2" Rebar at Occupied Fence Intersection
Theoretical Center of Section is N 51°19'05" E, 7.18 Feet

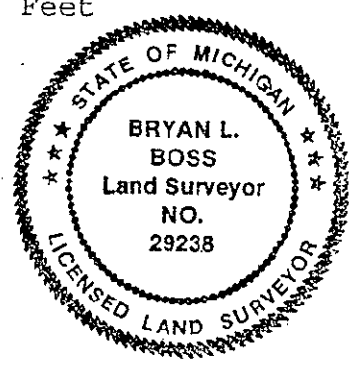

C. Description of monument for corner and accessories established to perpetuate locating the position of the corner:
Set 1 1/4" x 36" Iron Pipe with Brass Cap
(Livingston Co. Monument Corner)

North 20.26' Spike 15" Cherry
N85°E 37.34' Spike 8" Cherry
South 3.00' Spike 10" Walnut
S85°W 34.97' Spike 12" Walnut

Approved by Livingston Co.
Monumentation Peer Group
on September 15, 1993

Signed by [Signature] Date June 8, 1994
Surveyor's Michigan License No. 29238

PA. 345 1980, APPROVED BY LIVINGSTON COUNTY
PEER GROUP ON 15 Sep '93

SUMMARY J-12


Center Section 35 Hamburg Township T1N-R5E

Found 1/2" iron rod and Boss Engineering cap, at occupied fence intersection. Iron set November 6, 1989 by Gary Boss Land Corner Recordation Certificate #1434. Computed theoretical center of section is N 51°19'05" E, 7.18 feet. This corner used is the capped iron at fence intersection.

Bryan L. Boss, P.S. 29238

Bryan L. Boss

File: J-12HSUM

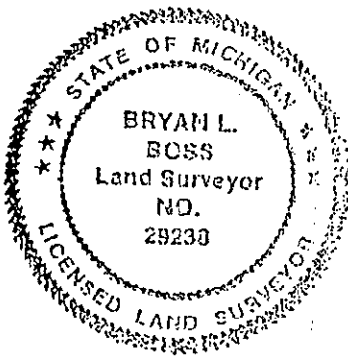

W/4

