

OCT 26 1995

COMMISSION

LAND CORNER RECORDATION CERTIFICATE
Filing Requirement of Act 74, Mich. P.A. 1970

For corners in

<u>Livingston</u> <small>(County)</small>	Located In:	Corner Code <u>##</u>
1. Public Land Survey	T <u>1N</u> R <u>5E</u>	<u>K-7</u>
	T _____ R _____	_____
	T _____ R _____	_____
	T _____ R _____	_____
2. Property Controlling in Section	S _____ T _____ R _____	_____
	S _____ T _____ R _____	_____
3. Miscellaneous Property in Sec.	S _____ T _____ R _____	_____
	S _____ T _____ R _____	_____

Nancy Haviland
 REGISTER OF DEEDS
 LIVINGSTON COUNTY, MI
 48843
 Oct 4 3 19 PM '95

REEDED

L. S. C. #450m
Register of Deeds Stamp & File Number

4. Lot No. _____, Recorded Plat _____
5. Private Claims _____

	A	B	C	D	E	F	G	H	I	J	K	L	M
2	6	5	4	3	2	1							
3													
4	7	8	9	10	11	12							
5													
6	18	17	16	15	14	13							
7													
8	19	20	21	22	23	24							
9													
10	30	29	28	27	26	25							
11													
12	31	32	33	34	35	36							
13													

I, Bryan Boss, in a field survey on 8-21, 19 95, do hereby certify that under requirements of P.A. 74, Michigan P.A. of 1970, the corner points mentioned in lines 1 and 2 above were in conformance with regulations and rules therefore as required in the current manual of survey instructions of the United States Department of the Interior, Bureau of Land Management or by a decree of a Court of Law and/or that the corner points mentioned in lines 3, 4 and 5 above were in conformance with the rules of the Michigan Board of Land Surveyors or by a Decree of a Court of Law; established, re-established, monumented, re-monumented, recovered, found as expressed below:

NOTE: Not more than 4 corners, all in the same town and range, may be recorded on this certificate.

A. Description of original monument and accessories and/or subsequent restoration:


- White Oak 20" N 76 W 99 links
- White Oak 13" N 83 E 1.63
- Hickory N 32 98 links
- Black Oak 24" N 89° 1/2 W 1.00

B. Description of corner evidence found and/or method applied in restoring or reestablishing corner:

- Found concrete monument one foot South of East & West fence line.
- West 10.15' nail South side fence post
- North 0.59' P.K. nail in fence corner post
- South 22.47' nail West side 10" Cedar
- Southwest/Northwest corner house No. 6891-153.85

C. Description of monument for corner and accessories established to perpetuate locating the position of the corner:

- Set brass cap in 36" pipe at ground surface.
- 0.63' North nail & tag East side fence post
- 65.27' N 85° E nail & tag South side 8" Cedar
- 22.12' South nail & tag east side 8" Cedar
- 10.08' N 85° W nail & tag South side fence post

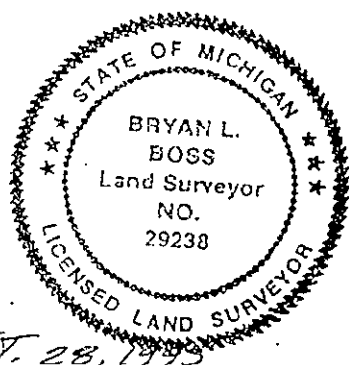

Signed by Bryan Boss

Date Sept. 28, 1995

Surveyor's Michigan License No. 29238


SUMMARY
K-7

Found concrete monument 1 foot \pm South of East and West fence line. Open field to the North and occupation to the South.

This corner is also open for G.P.S. on 6-6-74 and 4-17-76, Patrick L. Benton found $\frac{1}{2}$ " pipe and witnessed same, see pages 15 and 16 this dossier. Benton's tie-in distance to the North $\frac{1}{4}$ corner of Section 24 checks within 0.30 feet of "Winans View" Plat, see page 13 & 14. On April 12, 1982, Pat Benton's 4" pine tree witnesses have changed to cedar trees on Norman Fahrner's Act 74 on page 17 and 18. Then on April 11, 1983, Boss Engineering witnesses revert back to 4" pines, but still agree with Pat Benton 1976 corner. This also holds true with Boss Engineering survey on 2-23-93. In 1992 Boss Engineering also platted "Quail Run", Liber 29, pages 18 through 20, and set monument at Northeast corner of Section 23 in Spring of 1993.

In 1994 Boss Engineering also platted "Eagle Run", Liber 1848 pages 793 through 809 and submitted Act 74 on June 30, 1994. This Act 74 described concrete monument found, which was previously set upon recordation of "Quail Run".

We recommend accepting concrete monument as found to be the Northwest corner of Section 24 Hamburg Township.

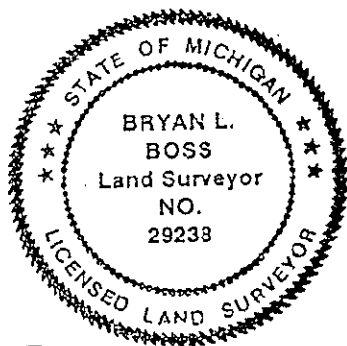

Bryan L. Boss