

OCT 26 1995

COMMISSION

LAND CORNER RECORDATION CERTIFICATE
Filing Requirement of Act 74, Mich. P.A. 1970

For corners in
Livingston

Located In: Corner Code #

Public Land Survey	T	1N	R	5E	K-10
	T		R		
	T		R		
	T		R		
Property Controlling in Section	S		T	R	
	S		T	R	
Miscellaneous Property in Sec.	S		T	R	
	S		T	R	

OCT 6 11 58 AM '95
FILED
NANCY HAVILAH
REGISTER OF DEEDS
LIVINGSTON COUNTY, MI
48343

L.S.C.#472m

Register of Deeds Stamp & File Number

Lot No. _____, Recorded Plat _____
Private Claims _____

Bryan Boss, in a field survey on 9-26, 1995

I hereby certify that under requirements of P.A. 74, Michigan P.A. of 1970, the corner points mentioned in lines 1 and 2 above were in conformance with regulations and rules therefore as required in the current manual of survey instructions of the United States Department of the Interior, Bureau of Land Management or by a decree of a Court of Law and/or that the corner points mentioned in lines 3, 4 and 5 above were in conformance with the rules of the Michigan Board of Land Surveyors or by a Decree of a Court of Law; established, re-established, monumented, re-monumented, recovered, found as expressed below:

NOTE: Not more than 4 corners, all in the same town and range, may be recorded on this certificate.

A	B	C	D	E	F	G	H	I	J	K	L	M
2	6	5	4	3	2	1						
3												
4	7	8	9	10	11	12						
5												
6	18	17	16	15	14	13						
7												
8	19	20	21	22	23	24						
9												
10	30	29	28	27	26	25						
11												
12	31	32	33	34	35	36						
13												

Description of original monument and accessories and/or subsequent restoration:


White Oak 20" S 72 1/2 E 7.25 links
No other timber near

Description of corner evidence found and/or method applied in restoring or reestablishing corner:

Found 1 1/2" pipe over 1/4 in rerod
6" multiple Ash S 15° W 37.5 to nail
3" multiple Ash N 15° E 19.85 to nail
2" multiple Ash N 80° E 10.49' to nail
3" Poplar S 10° E 40.11' to nail

Description of monument for corner and accessories established to perpetuate locating the position of the corner:

Set brass cap in 36" pipe at grade level
37.58' north 3/4" pipe centerline old railroad tracks
10.27' N 45° E nail & tag west side 5" twin tree
35.66' S 20° W nail east side 14" Willow
43.46' N 30° W nail south side 8" Willow

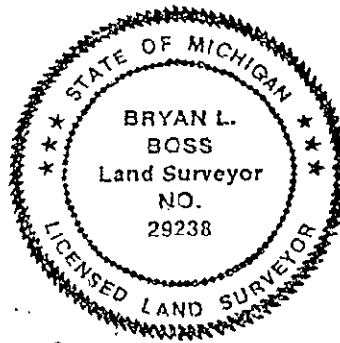

Recorded by Bryan L. Boss Date Oct. 4, 1995
Surveyor's Michigan License No. 29238

SUMMARY

K-10

WEST $\frac{1}{4}$ CORNER, SECTION 25, T1N-R5E, HAMBURG TOWNSHIP, LIVINGSTON COUNTY, MICHIGAN


Found 1 $\frac{1}{2}$ " pipe over $\frac{1}{4}$ " iron rod. 217 feet \pm North of centerline of Ann Arbor railroad track and 37.58 feet South of 3/4" pipe in centerline of abandoned railroad tracks. Area is open for G.P.S.

Lyle Munsell, in 1956, ran East & West $\frac{1}{4}$ line of Section 25, but tie in distance stopped at centerline of stream East of West $\frac{1}{4}$ corner of Section 25. On January 17, 1974, Charles C. Wilson states he found a $\frac{1}{4}$ " iron rod and subsequent survey indicated this point is same as previously used.

Witnesses by Wilson, Erickson and Boss Engineering concur as to location of 1 $\frac{1}{2}$ " pipe over $\frac{1}{4}$ " rod.

Patrick Benton's 1979 field notes indicate a found East $\frac{1}{4}$ corner 216.50 feet North of $\frac{1}{4}$ " iron at South R.O.W. Ann Arbor Railroad (see pages 16 & 18 this dossier). A clean sweep of the area found no other irons.

Conclusion: We find the 1 $\frac{1}{2}$ " pipe over $\frac{1}{4}$ " iron rod (as described by others) to be the West $\frac{1}{4}$ corner of Section 25.

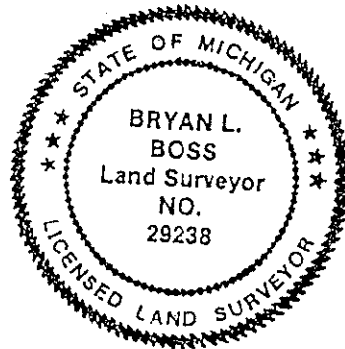

Bryan L. Boss