

1996 NOV 25 A 9:39

LAND CORNER RECORDATION CERTIFICATE
Filing Requirement of Act 74, Mich. P.A. 1970

NANCY HAVILAND
REGISTER OF DEEDS
LIVINGSTON COUNTY, MI.
48843

For corners in

<u>Livingston</u> <small>(County)</small>	Located In:	Corner Code <u>L-5</u>
1. Public Land Survey	T <u>1</u> N R <u>5E</u>	<u>L-5</u>
	T <u> </u> R <u> </u>	<u> </u>
	T <u> </u> R <u> </u>	<u> </u>
	T <u> </u> R <u> </u>	<u> </u>
2. Property Controlling in Section	S <u> </u> T <u> </u> R <u> </u>	<u> </u>
	S <u> </u> T <u> </u> R <u> </u>	<u> </u>
3. Miscellaneous Property in Sec.	S <u> </u> T <u> </u> R <u> </u>	<u> </u>
	S <u> </u> T <u> </u> R <u> </u>	<u> </u>

L.S.C.#612m

Register of Deeds Stamp & File Number

4. Lot No. _____, Recorded Plat _____
5. Private Claims _____

A	B	C	D	E	F	G	H	I	J	K	L	M
2	6	5	4	3	2	1						
3												
4	7	8	9	10	11	12						
5												
6	13	17	16	15	14	13						
7												
8	19	20	21	22	23	24						
9												
10	30	29	28	27	26	25						
11												
12	31	32	33	34	35	36						
13												

I, Bryan Boss, in a field survey on August 15, 1996, do hereby certify that under requirements of P.A. 74, Michigan P.A. of 1970, the corner points mentioned in lines 1 and 2 above were in conformance with regulations and rules therefore as required in the current manual of survey instructions of the United States Department of the Interior, Bureau of Land Management or by a decree of a Court of Law and/or that the corner points mentioned in lines 3, 4 and 5 above were in conformance with the rules of the Michigan Board of Land Surveyors or by a Decree of a Court of Law; established, re-established, monumented, re-monumented, recovered, found as expressed below:

NOTE: Not more than 4 corners, all in the same town and range, may be recorded on this certificate.

A. Description of original monument and accessories and/or subsequent restoration:


- Black Oak 8" N 5 1/2° E 1.00
- White Oak 6" S 80 1/2° W 1.67

B. Description of corner evidence found and/or method applied in restoring or reestablishing corner:

Found 1/2" Iron Rod 0.6 tenths deep
No occupation

C. Description of monument for corner and accessories established to perpetuate locating the position of the corner:

- Set 1 1/2" Iron pipe 36" in length with Brass cap
- Stamped Livingston County Monumentation Corner
- N 10° E 35.45' nail & tag west side 14" cherry
- S 10° E 15.74' nail & tag east side twin poplar
- S 85° W 71.26' Northeast corner block garage
- N 85° W 91.58' Northeast corner house
- N 40° W 38.33' nail & tag east side 8" hickory

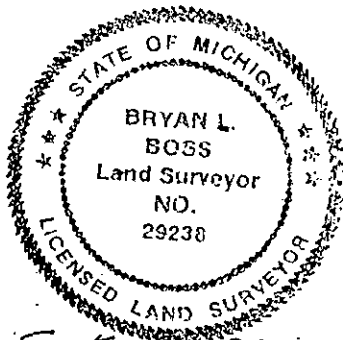

Signed by Bryan L. Boss
Surveyor's Michigan License No. 29238

Date Sept. 20, 1996

SUMMARY

L-5

South ¼ Corner, Section 12, T1N-R5E, Hamburg Township, Livingston County,
Michigan


Found ½" iron rod 0.6 tenths deep. No visible occupation in any direction. Open area
for G.P.S.

On November 11, 1926, Grant Dunning records distance of 1101 feet from South ¼
Corner, Section 12, Westerly to West right-of-way of 66 wide public highway. This
same line was measured by Clay Gordon in 1940 at a distance of 1067 feet from North
¼ Corner, Section 13 to centerline of highway Westerly. In 1977, Patrick Benton
survey on Page 21, this dossier, again measured same line and recorded distance of
1066.5 feet and also witnessed found ¼" iron rod. Two of these witnesses were found
on Patrick Bentons 1980 survey on Page 22.

Subsequent surveys by Boss Engineering and Progressive also record same witnesses
with a ½" to 3/8" iron rod found.

Note on Page 29, march 14, 1996, Boss Engineering found 3 witnesses check.

Therefore, we find the ½" iron rod, as found to be the South ¼ Corner of Section 12,.

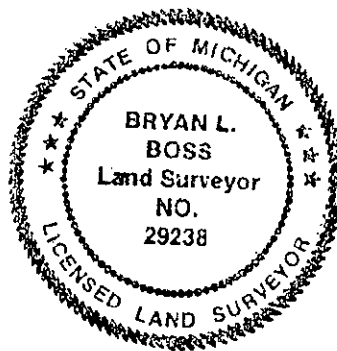

file: summl-5

A handwritten signature in cursive script that reads "Bryan L. Boss".