

FILED

DEC 29 11 25 AM '93

LAND CORNER RECORDATION CERTIFICATE

Filing Requirement of Act 74, Mich. P.A. 1970

NANCY HAVILAND  
REGISTER OF DEEDS  
LIVINGSTON COUNTY, MI  
48843

For corners in

Livingston Located In: \_\_\_\_\_ Corner Code M-1

1. Public Land Survey T 1N R 5E \_\_\_\_\_ M-1  
 T \_\_\_\_\_ R \_\_\_\_\_  
 T \_\_\_\_\_ R \_\_\_\_\_  
 T \_\_\_\_\_ R \_\_\_\_\_

2. Property Controlling S \_\_\_\_\_ T \_\_\_\_\_ R \_\_\_\_\_  
 in Section S \_\_\_\_\_ T \_\_\_\_\_ R \_\_\_\_\_

3. Miscellaneous S \_\_\_\_\_ T \_\_\_\_\_ R \_\_\_\_\_  
 Property in Sec. S \_\_\_\_\_ T \_\_\_\_\_ R \_\_\_\_\_

4. Lot No. \_\_\_\_\_, Recorded Plat \_\_\_\_\_

5. Private Claims \_\_\_\_\_

L.S.C. #174m  
Register of Deeds Stamp & File Number

I, Bryan Boss, in a field survey on December 22, 1993, do hereby certify that under requirements of P.A. 74, Michigan P.A. of 1970, the corner points mentioned in lines 1 and 2 above were in conformance with regulations and rules therefore as required in the current manual of survey instructions of the United States Department of the Interior, Bureau of Land Management or by a decree of a Court of Law and/or that the corner points mentioned in lines 3, 4 and 5 above were in conformance with the rules of the Michigan Board of Land Surveyors or by a Decree of a Court of Law; established, re-established, monumented, re-monumented, recovered, found as expressed below:

NOTE: Not more than 4 corners, all in the same town and range, may be recorded on this certificate.

A. Description of original monument and accessories and/or subsequent restoration:

- B. Oak 8 in. Dia. S27W 25 Lks.
- B. Oak 8 in. Dia. N12E 19 Lks.

SURVEY &  
RECORDATION

1993

COMMISSION

B. Description of corner evidence found and/or method applied in restoring or reestablishing corner:

Found 1" Pipe in 24" Square Concrete Pad  
This is a Common Corner for 4 Townships

C. Description of monument for corner and accessories established to perpetuate locating the position of the corner:

Set Brass Cap Marked: Livingston Co.  
Mon. Corner in Existing Pipe Encased in  
2' Square Concrete


- N5°W 34.70' Spike E/Side 16" Oak
- West 5.54' Spike S/Side 16" Oak
- East 2.92' Spike S/Side 10" Oak
- East 26.37' Spike S/Side 18" Oak

Approved by Livingston Co.  
Monumentation Peer Group  
on November 6, 1993

Signed by

*Bryan L. Boss*

Surveyor's Michigan License No. 29238

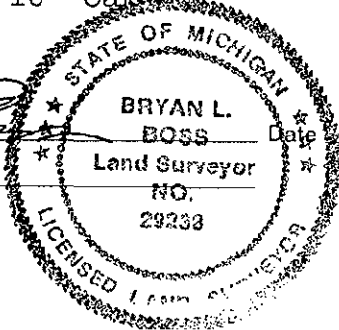

December 28, 1993