

1996 NOV 25 A 9:39

LAND CORNER RECORDATION CERTIFICATE
Filing Requirement of Act 74, Mich. P.A. 1970

NANCY HAVILAND
REGISTER OF DEEDS
LIVINGSTON COUNTY, MI.
48843

For corners in

<u>Livingston</u> (County)	Located in:	Corner Code #
1. Public Land Survey	T <u>1N</u> R <u>5E</u>	<u>M-5</u>
	T ___ R ___	_____
	T ___ R ___	_____
	T ___ R ___	_____
2. Property Controlling in Section	S ___ T ___ R ___	_____
	S ___ T ___ R ___	_____
3. Miscellaneous Property in Sec.	S ___ T ___ R ___	_____
	S ___ T ___ R ___	_____

L.S.C.#614m

Register of Deeds Stamp & File Number

4. Lot No. _____, Recorded Plat _____
5. Private Claims _____

A	B	C	D	E	F	G	H	I	J	K	L	M
2	6	5	4	3	2							
3												
4	7	8	9	10	11	12						
5												
6	13	17	16	15	14	13						
7												
8	19	20	21	22	23	24						
9												
10	30	29	28	27	26	25						
11												
12	31	32	33	34	35	36						
13												

I, Bryan Boss, in a field survey on July 29, 1996, do hereby certify that under requirements of P.A. 74, Michigan P.A. of 1970, the corner points mentioned in lines 1 and 2 above were in conformance with regulations and rules therefore as required in the current manual of survey instructions of the United States Department of the Interior, Bureau of Land Management or by a decree of a Court of Law and/or that the corner points mentioned in lines 3, 4 and 5 above were in conformance with the rules of the Michigan Board of Land Surveyors or by a Decree of a Court of Law; established, re-established, monumented, re-monumented, recovered, found as expressed below:

NOTE: Not more than 4 corners, all in the same town and range, may be recorded on this certificate.

A. Description of original monument and accessories and/or subsequent restoration:

- Tamarack 10" S 10° W .11
- Tamarack 10" N 48° E .33


B. Description of corner evidence found and/or method applied in restoring or reestablishing corner:

Found 1/2" iron in concrete monument

C. Description of monument for corner and accessories established to perpetuate locating the position of the corner:

Set brass cap stamped Livingston County Remonumentation corner on existing monument

S 80° E 34.52 feet Nail & Tag South side 8" Cedar
 S 45° E 58.32 feet Nail & Tag South side 4" Ash
 N 10° W 14.91 feet Nail & Tag Southwest side 4" Tree

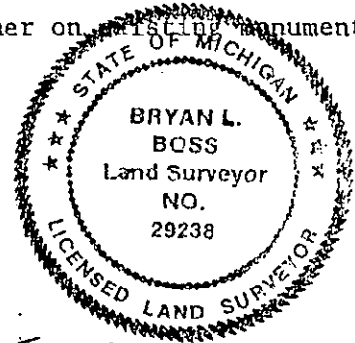

Signed by Bryan L. Boss Date Sept. 26, 1996
Surveyor's Michigan License No. 29238

SUMMARY

~~Approved 4-3-79
Pg 17 distance needed~~

M-5

Southeast Corner, Section 12, T1N-R5E, Hamburg Township, Livingston County,
Michigan

Found ¼" iron in concrete monument, and all original Tamarack witnesses are gone.


The "Supervisor's Plat of Ore Lake Resort Subdivision" was platted in 1953 and called for a distance of 476.46 feet South to Road Right-of-Way monument. On 10-20-66, Washtenaw Engineering measured South from Southeast Corner of Section 12 and recorded 477.28 feet to found concrete monument at right-of-way.

Page 17 of this dossier documents measured distance north from Southeast Corner, Section 12 to the West ¼ Corner of Section 7, Green Oak Township. On 5-31-77, Whitney Carnahan found monument recorded and measured North to centerline of Hammel Road 1200.34 feet, then continued North to West ¼, Section 7, Green Oak Township, 909.15 feet which totals 2109.49 feet. Carnahan also submits land corner recordation's certificate on 6-16-77.

On 8-23-77, Boss Engineering measured the same 1200.34 feet to centerline of Hammel Road, and continued to West ¼ Corner, Section 7, Green Oak Township measuring 908.72 feet, a total of 2109.06 feet.

Note on page 20 that on March 14, 1978, Boss Engineering measured South to monument at road right-of-way 476.46 feet, the same as 1953 plat of "Ore Lake Resort". This corner is in open area for G.P.S. We find this concrete monument to be at the same location as found or set in 1953 and recommend it's acceptance.

file: summm-5

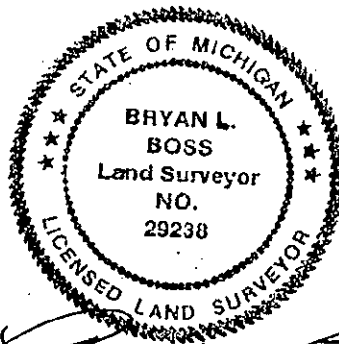

[Handwritten signature]