

OCT 26 1995

COMMISSION

LAND CORNER RECORDATION CERTIFICATE  
Filing Requirement of Act 74, Mich. P.A. 1970

For corners in

Livingston Located In: \_\_\_\_\_ Corner Code #/ #  
(County)

1. Public Land Survey T 1N R 5E \_\_\_\_\_ M-8  
T \_\_\_\_\_ R \_\_\_\_\_  
T \_\_\_\_\_ R \_\_\_\_\_  
T \_\_\_\_\_ R \_\_\_\_\_

2. Property Controlling S \_\_\_\_\_ T \_\_\_\_\_ R \_\_\_\_\_  
in Section S \_\_\_\_\_ T \_\_\_\_\_ R \_\_\_\_\_

3. Miscellaneous S \_\_\_\_\_ T \_\_\_\_\_ R \_\_\_\_\_  
Property in Sec. S \_\_\_\_\_ T \_\_\_\_\_ R \_\_\_\_\_

9-  
OCT 4 3 19 PM '95  
NANCY HAVILLAND  
REGISTER OF DEEDS  
LIVINGSTON COUNTY, MI  
48843

RECEIVED

L.S.C. #454m

Register of Deeds Stamp & File Number

4. Lot No. \_\_\_\_\_, Recorded Plat \_\_\_\_\_

5. Private Claims \_\_\_\_\_

	A	B	C	D	E	F	G	H	I	J	K	L	M
2	6		5		4		3		2		1		
3													
4	7		8		9		10		11		12		
5													
6	18		17		16		15		14		13		
7													
8	19		20		21		22		23		24		
9													
10	30		29		28		27		26		25		
11													
12	31		32		33		34		35		36		
13													

I, Bryan Boss, in a field survey on 9-18, 19 95, do hereby certify that under requirements of P.A. 74, Michigan P.A. of 1970, the corner points mentioned in lines 1 and 2 above were in conformance with regulations and rules therefore as required in the current manual of survey instructions of the United States Department of the Interior, Bureau of Land Management or by a decree of a Court of Law and/or that the corner points mentioned in lines 3, 4 and 5 above were in conformance with the rules of the Michigan Board of Land Surveyors or by a Decree of a Court of Law; established, re-established, monumented, re-monumented, recovered, found as expressed below:

NOTE: Not more than 4 corners, all in the same town and range, may be recorded on this certificate.

A. Description of original monument and accessories and/or subsequent restoration:


- Black Oak 13" S 12° W 70 links
- Black Oak 13" N 30° E 37 links
- Red Oak 20" N 70° E 20 links

B. Description of corner evidence found and/or method applied in restoring or reestablishing corner:

- Found concrete monument 0.6 feet East of North & South fence
- 12" Oak Easterly 36.90' to nail
- 18" Oak S 50° E 11.28' to nail
- 18" Oak N 55° W 31.21' to nail
- 12" Oak N 10° E 42.31' to nail

C. Description of monument for corner and accessories established to perpetuate locating the position of the corner:

- 36.90' East P.K. Nail RJD North side 12" Oak
- 38.68' S 45° W nail & tag East side 8" Oak
- 31.12' N 45° W nail & tag South side 18" Oak
- 42.31' N 10° E P.K. nail RJD East side 12" Oak
- 46.35' North monument 1.20 feet East of North & South fence.

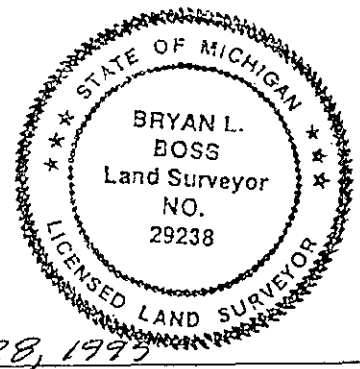

Signed by Bryan L. Boss Date Sept. 28, 1995

Surveyor's Michigan License No. 29238

SUMMARY


M-8

East  $\frac{1}{4}$  Corner Section 24, T1N-R5E Hamburg Township,  
Livingston County, Michigan.

Found concrete monument 0.6 feet East of North & South  
fence. Also found concrete monument 46.35 feet North and  
1.2 feet East of fence. All witnesses on sheet 7 of this  
dossier check to monument which was set by Huron-Clinton  
Metropolitan Authority on 4-16-66 (see Sheet 12). Note  
indicates area was surveyed 25 years prior to 1966 by  
H.C.M.A. The corner is heavily wooded and not conducive for  
G.P.S. station.

Conclusion: We find the East  $\frac{1}{4}$  Corner of Section 24 to be  
the monument as found and witnessed.

HAMM-8S

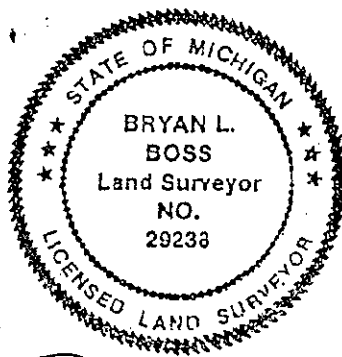

*Bryan L. Boss*