

OCT 26 1995

COMMISSION

LAND CORNER RECORDATION CERTIFICATE

Filing Requirement of Act 74, Mich. P.A. 1970

For corners in

<u>Livingston</u> <small>(County)</small>	Located In:	Corner Code <u>##</u>
1. Public Land Survey	T <u>1N</u> R <u>5E</u>	<u>M-10</u>
	T _____ R _____	_____
	T _____ R _____	_____
	T _____ R _____	_____
2. Property Controlling in Section	S _____ T _____ R _____	_____
	S _____ T _____ R _____	_____
3. Miscellaneous Property in Sec.	S _____ T _____ R _____	_____
	S _____ T _____ R _____	_____

OCT 6 11 56 AM '95  
 FILED  
 HANCKY HAYILANE  
 REGISTER OF DEEDS  
 LIVINGSTON COUNTY, MI  
 48845

L.S.C. #475m  
 Register of Deeds Stamp & File Number

4. Lot No. \_\_\_\_\_, Recorded Plat \_\_\_\_\_  
 5. Private Claims \_\_\_\_\_

	A	B	C	D	E	F	G	H	I	J	K	L	M
2	6		5		4		3		2		1		
3													
4	7		8		9		10		11		12		
5													
6	18		17		16		15		14		13		
7													
8	19		20		21		22		23		24		
9													
10	30		29		28		27		26		25		
11													
12	31		32		33		34		35		36		
13													

I, Bryan Boss, in a field survey on 8-21, 19 95, do hereby certify that under requirements of P.A. 74, Michigan P.A. of 1970, the corner points mentioned in lines 1 and 2 above were in conformance with regulations and rules therefore as required in the current manual of survey instructions of the United States Department of the Interior, Bureau of Land Management or by a decree of a Court of Law and/or that the corner points mentioned in lines 3, 4 and 5 above were in conformance with the rules of the Michigan Board of Land Surveyors or by a Decree of a Court of Law; established, re-established, monumented, re-monumented, recovered, found as expressed below:

NOTE: Not more than 4 corners, all in the same town and range, may be recorded on this certificate.

A. Description of original monument and accessories and/or subsequent restoration:


- Hickory 8" N 10° W 2.40 chains
- Hickory 6" North 2.95 chains
- Black Oak 7" N 88° W 18

B. Description of corner evidence found and/or method applied in restoring or reestablishing corner:

- Found 1/2 inch iron in concrete, occupation North, South and West
- N 10° E 16" Wild Cherry 15.94'
- S 85° E 8" Wild Cherry 9.19'
- S 65° W 16" Oak 9.03'
- S 18° W 12" Oak 9.10'

C. Description of monument for corner and accessories established to perpetuate locating the position of the corner:

- Set brass cap in 36" pipe at grade level
- 22.06' North nail & tag West side 10" Cherry
- 25.69' S 5° W nail & tag East side 12" Oak
- 9.08' S 65° W nail & tag North side 20" Hickory
- 14.11' N 45° W nail & tag South side 8" Cherry

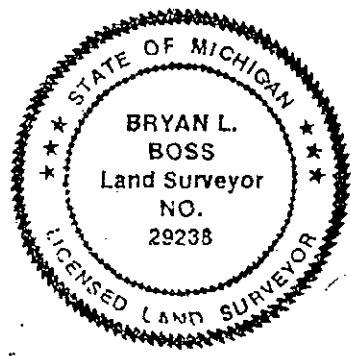

Signed by Bryan L. Boss Date Oct 4, 1995  
 Surveyor's Michigan License No. 29238

SUMMARY

M-10


East  $\frac{1}{4}$  Corner Section 25, T1N-R5E Hamburg Township,  
Livingston County, Michigan.

Found  $\frac{1}{2}$ " iron in concrete occupational tree row and fenced  
North, South and West. Area open to the East but corner  
will be difficult for G.P.S. due to heavily wooded corner.

Land corner recordation certificates by Marvin D. Pike in  
1974 (pages 13-14) and Brad F. Thompson in 1993 agree on  
findings. G.L.O. calls for 873 links (576.18 feet) but  
actual measurements were found to be 453.98 feet from East  $\frac{1}{4}$   
corner of Section 25 to the West  $\frac{1}{4}$  corner of Section 30,  
T1N-R6E Green Oak Township. Number 8 witness on page 7  
witness sheet appears to be same as Miles Bullock witness in  
1876 on page 10 of this dossier.

Conclusion: We find the 1974  $\frac{1}{2}$ " rod in concrete to be the  
same  $\frac{1}{2}$  iron found on 2-15-95 and recommend its acceptance.

HAMM-10S

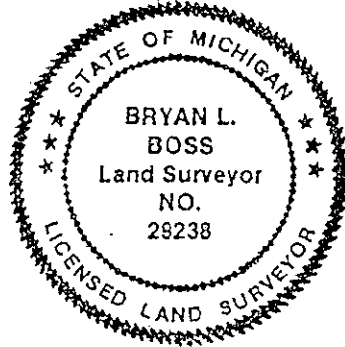

*Bryan L. Boss*