

SURVEY & REMONUMENTATION

FILED

APR 28 1995 LAND CORNER RECORDATION CERTIFICATE
Filing Requirement of Act 74, Mich. P.A. 1970

NOV 16 2 07 PM '94

For corners in
Livingston
(County)

COMMISSION

	Located In:		Corner Code #/
	1N	5E	
1. Public Land Survey	T _____	R _____	M-11
	T _____	R _____	
	T _____	R _____	
	T _____	R _____	
2. Property Controlling In Section	S _____	T _____	R _____
	S _____	T _____	R _____
3. Miscellaneous Property in Sec.	S _____	T _____	R _____
	S _____	T _____	R _____

NANCY HAVILAND
REGISTER OF DEEDS
LIVINGSTON COUNTY, MI
48843

L.S.C. #385m

Register of Deeds Stamp & File Number

4. Lot No. _____, Recorded Plat _____
5. Private Claims _____

Bryan Boss

October 21

94

I, _____, in a field survey on _____, 19____, do hereby certify that under requirements of P.A. 74, Michigan P.A. of 1970, the corner points mentioned in lines 1 and 2 above were in conformance with regulations and rules therefore as required in the current manual of survey instructions of the United States Department of the Interior, Bureau of Land Management or by a decree of a Court of Law and/or that the corner points mentioned in lines 3, 4 and 5 above were in conformance with the rules of the Michigan Board of Land Surveyors or by a Decree of a Court of Law; established, re-established, monumented, re-monumented, recovered, found as expressed below:

NOTE: Not more than 4 corners, all in the same town and range, may be recorded on this certificate.

A. Description of original monument and accessories and/or subsequent restoration:

Red Oak 16" S 30 W 15 Links
Red Oak 12" S 69 W 25 Links

Additional data on back.

	A	B	C	D	E	F	G	H	I	J	K	L	M
2	6	5	4	3	2	1							
3													
4	7	8	9	10	11	12							
5													
6	18	17	16	15	14	13							
7													
8	19	20	21	22	23	24							
9													
10	30	29	28	27	26	25							
11													
12	31	32	33	34	35	36							
13													

B. Description of corner evidence found and/or method applied in restoring or reestablishing corner:


Found 1/2" Inch capped rerod #24607 North of Southwest Corner of Section 30, T1N-R6E, Green Oak Township. Calculated straight line from East 1/4 corner Section 36, T1N-R5E, Hamburg Township to East 1/4 Corner Section 35, of said Hamburg Township. Held G.L.O. distance from SW Corner, Section 30, T1N-R6E, Green Oak. Measured 8.94 chains (590.04 feet): M-11 to be reset N89°47'51"W 16.82 feet from existing location.

C. Description of monument for corner and accessories established to perpetuate locating the position of the corner:

Set 1" x 36" pipe with brass cap marked
Livingston County Monument Corner

North 28.09 Remon. Tag 6" Cherry
S60°W 19.80' Remon. Tag 6" Poplar
S10°E 21.20 Remon. Tag 10" Burr Oak
East 1.97' Remon. Tag 14" Oak

Approved by Livingston Co.
Monumentation Peer Group
11-13-93

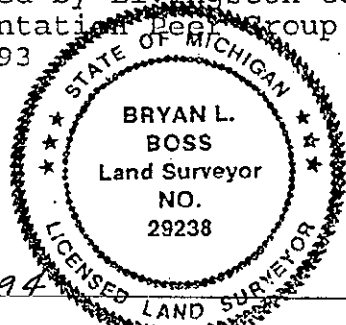

Signed by Bryan L. Boss Date 11-16-1994
Surveyor's Michigan License No. 29238

FORM APPROVED BY MICHIGAN STATE BOARD OF LAND SURVEYORS, JAN. 28, 1971
REVISED MAY 14, 1975
REVISED JAN., 1983

PA. 345 1990, APPROVED BY LIVINGSTON COUNTY
PEER GROUP ON 13 Nov. 93 CO. REP Bryan L.

SUMMARY

M-11

Northeast Corner, Section 36, T1N-R5E, Hamburg Township, Livingston County, Michigan.

Found a 1/2" capped rerod #24607 Christopher Newman 16.82 feet east and 0.06 hundredths south of calculated corner.

Original east boundary of Hamburg Township was surveyed December 14, 1815 by Sibley. Miles Bullock surveyed the Northeast 1/4 of Section 36 on March 8, 1969. On August 6, 1929 Clay Gordon measured from N 1/4 post to NE Corner of Section 36 (U.S. 40.08 chains, Miles Bullock 40.14 chains, Clay Gordon 2649.24 feet). Records indicate William J. Miller also surveyed East line of Section in 1932. On 7-12-57 Harry H. Atwell surveyed all of Section 36.

Patrick Benton in 1979 split parcels North and East utilizing occupation. On 7-28-77, Charles Garlock measured Southerly from NE Corner of Section 36 and described two parcels with an easement. Christopher Newman of Tri-County Survey set 1/2" inch rerod and recorded Corner on March 2, 1992 on L.S.C. #1534. Note: North and South fence found 10 feet± West of Corner set.

Recommend resetting Corner 16.82 feet West and 0.06 feet South of existing location.

hamm-11

