

**SURVEY &
REMONUMENTATION**

MAR 17 2000

FILED

SECTION

**LAND CORNER RECORDATION CERTIFICATE
Filing Requirement of Act 74, Mich. P.A. 1970**

1999 NOV 22 A 11:09

For corners in
LIVINGSTON
(County)

Located in: HAMBURG Corner Code # 9

NANCY HAVILAND
REGISTER OF DEEDS
LIVINGSTON COUNTY, MI.
48843


1. Public Land Survey	T	<u>1N</u>	R	<u>5E</u>	G-9
	T		R		
	T		R		
	T		R		
2. Property Controlling In Section	S		T		R
	S		T		R
3. Miscellaneous Property in Sec.	S	<u>21</u>	T	<u>1N</u>	R
	S	<u>28</u>	T	<u>1N</u>	R
					<u>SE</u>
					<u>SE</u>

LSC# 1123m
Register of Deeds Stamp and File Number

4. Lot No. _____, Recorded Plat _____
5. Private Claims _____

I, Bryan L. Boss, In a field survey on OCT. 28, 1999
do hereby certify that under requirements of P.A. 74, Michigan P.A. of 1970, the corner points mentioned in lines 1 and 2 above were in conformance with regulations and rules therefor as required in the current manual of survey instructions of the United States Department of the Interior, Bureau of Land Management or by a decree of a Court of Law and/or that the corner points mentioned in lines 3, 4 and 5 above were in conformance with the rules of the Michigan Board of Land Surveyors or by a Decree of a Court of Law, established, re-established, monumented, re-monumented, recovered, found as expressed below.

NOTE: Not more than 4 corners, all in the same town and range, may be recorded on this certificate.

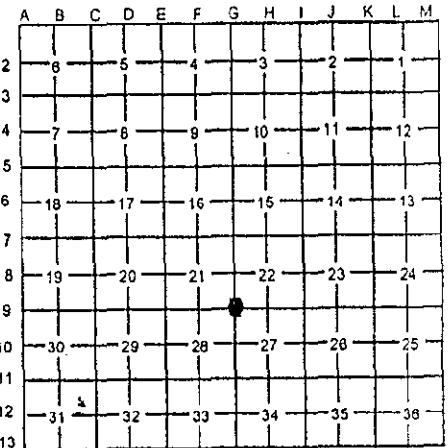

A. Description of original monument and accessories and/or subsequent restoration:
CORNER NOT SET IT IS IN ZUKEY LAKE


B. Description of corner evidence found and/or method applied in restoring or reestablishing corner:

CORNER LOCATION ESTABLISHED FROM PREVIOUS SURVEY DATA BY CLAY GORDON (1934)	CORNER G-9 TO REF. PT. 1 S86°21'37"W, 244.50' (011)
CORNER ESTABLISHED AS BEING 244.50 FEET EAST OF A 3/8" IRON ROD ON THE WEST SHORE OF ZUKEY LAKE ALONG A PREVIOUSLY SURVEYED AND MONUMENTED LINE.	CORNER G-9 TO REF. PT. 2 S02°24'45"E, 577.97' (012)
REFERENCE POINT 1 (WEST OF CORNER) (011)	REF. PT. 1 TO REF. PT. 2 S26°19'00"E, 626.38'
THIS POINT IS LOCATION OF 3/8" IRON ROD FOUND ON THE MONUMENTED SECTION LINE BETWEEN SECTION 21 AND 28 15 FEET MORE OR LESS WEST OF THE WEST SHORE OF ZUKEY LAKE	REFERENCE POINT 2 (SOUTH OF CORNER) (012)
	SET REMON PIPE AND CAP AT POINT 4 FEET SOUTH OF THE SOUTH SHORE OF ZUKEY LAKE 60 FEET MORE OR LESS EAST OF A WATERWAY RUNNING NORTH-SOUTH BETWEEN ZUKEY LAKE AND STRAWBERRY LAKE

C. Description of monument for corner and accessories established to perpetuate locating the position of the corner:

REFERENCE POINT 1 - 011	REFERENCE POINT 2 - 012
SET 1 1/4" X 36" PIPE WITH BRASS CAP STAMPED "LIVINGSTON COUNTY REMONUMENTATION WITNESS" OVER FOUND 3/8" IRON ROD	SET 1 1/4" X 36" IRON PIPE WITH BRASS CAP STAMPED "LIVINGSTON COUNTY REMONUMENTATION WITNESS"
N10°W 5.05' SET REMON NAIL & TAG E/S 24" OAK	WEST 22.61' SET REMON NAIL & TAG N/S 18" COTTONWOOD
S80°W 16.29' SET REMON NAIL & TAG N/S 10" OAK	SOUTH 83.76' NW COR. OF HOUSE FOUNDATION
S10°W 34.86' NE CORNER BROWN HOUSE	S45°E 22.22' SET REMON NAIL & TAG NE/S 12" ASH
N10°W 4.32' FOUND 1/2" IRON ROD	EAST 117.85' FOUND CONCRETE MONUMENT
SOUTH 33.11' NE CORNER SECOND DECK CORNER POST	

P.A. 345 1990, APPROVED BY LIVINGSTON COUNTY
PEER GROUP ON 9-1-99, CO. REP JED

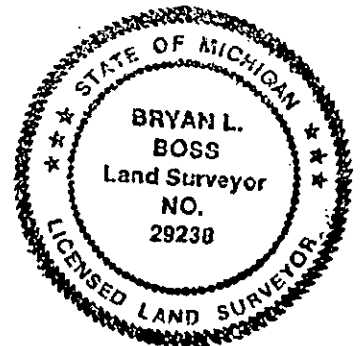

Signed by Bryan L. Boss Date NOV 12 1999
Surveyor's Michigan License No. 29238