

SURVEY & REMONUMENTATION

MAR 17 2000

FILED

SECTION

LAND CORNER RECORDATION CERTIFICATE
Filing Requirement of Act 74, Mich. P.A. 1970

1999 NOV 22 A 11:09

For corners in
LIVINGSTON
(County)

Located in: HAMBURG Corner Code # 9

NANCY HAVILAND
REGISTER OF DEEDS
LIVINGSTON COUNTY, MI.
48843

1. Public Land Survey	T	<u>1N</u>	R	<u>5E</u>	G-10
	T		R		
	T		R		
	T		R		
2. Property Controlling in Section	S		T	R	
	S		T	R	
3. Miscellaneous Property in Sec.	S	<u>28</u>	T	<u>1N</u>	R <u>5E</u>
	S	<u>28</u>	T	<u>1N</u>	R <u>5E</u>

LSC# 1124m

Register of Deeds Stamp and File Number

4. Lot No. _____, Recorded Plat _____
5. Private Claims _____

I, Bryan L. Boss, in a field survey on OCT. 28, 1999, do hereby certify that under requirements of P.A. 74, Michigan P.A. of 1970, the corner points mentioned in lines 1 and 2 above were in conformance with regulations and rules therefor as required in the current manual of survey instructions of the United States Department of the Interior, Bureau of Land Management or by a decree of a Court of Law and/or that the corner points mentioned in lines 3, 4 and 5 above were in conformance with the rules of the Michigan Board of Land Surveyors or by a Decree of a Court of Law; established, re-established, monumented, re-monumented, recovered, found as expressed below.

NOTE: Not more than 4 corners, all in the same town and range, may be recorded on this certificate.


	A	B	C	D	E	F	G	H	I	J	K	L	M
2	5	5	4	3	2	1							
3													
4	7	8	9	10	11	12							
5													
6	13	17	16	15	14	13							
7													
8	19	20	21	22	23	24							
9													
10	30	29	28	27	26	25							
11													
12	31	32	33	34	35	36							
13													

A. Description of original monument and accessories and/or subsequent restoration:
CORNER NOT SET BECAUSE IT IS IN LAKE

B. Description of corner evidence found and/or method applied in restoring or reestablishing corner:
LOCATION FOR CORNER ESTABLISHED AT SINGLE PROPORTIONATE DISTANCE FROM CORNER G-9 TO G-11 (5172.68') THIS LOCATION IS PERPETUATED BY 2 REFERENCE MONUMENTS ESTABLISHED ON THE WEST SIDE AND NORTH SIDE OF STRAWBERRY LAKE
REFERENCE POINT 1 (013)
REFERENCE POINT 1 IS A FOUND CONCRETE MONUMENT 15 FEET WEST OF THE WEST SHORE OF STRAWBERRY LAKE ON THE APPARENT PROPERTY LINE BETWEEN HOUSES #4831 AND 4837 DOWNING DRIVE
G-10 TO REF. PT. 1 S86°49'22"W, 788.00' (013)
G-10 TO REF. PT. 2 N02°24'45"W, 1026.55' (014)
REF. PT. 1 TO REF. PT. 2 N33°29'37"E, 1279.51'
REFERENCE POINT 2 (014)
REFERENCE POINT 2 IS SET ON THE LINE BETWEEN G-9 & G-10 1026.55 FEET NORTH OF G-10. THIS POINT IS 3 FT NORTH OF THE WOOD WALL ALONG THE NORTH SHORE OF STRAWBERRY LAKE 150 FT NE OF THE SOUTH POINT OF THE PENINSULA IN THE LAKE

C. Description of monument for corner and accessories established to perpetuate locating the position of the corner:
REFERENCE POINT 1 (013)
SET BRASS CAP STAMPED "LIVINGSTON COUNTY REMONUMENTATION WITN" ON AN EXISTING CONCRETE MONUMENT
N10°W 16.38' SET REMON NAIL & TAG E/SIDE 18" MAPLE
WEST 21.31' SET REMON NAIL & TAG S/SIDE 24" MAPLE
SOUTH 69.48' SET NAIL & TAG W/SIDE 36" W. OAK
N45°W 47.15' NE CORNER HOUSE #4831
REFERENCE POINT 2 (014)
SET 1 1/4" X 36" PIPE WITH BRASS CAP STAMPED "LIVINGSTON COUNTY REMONUMENTATION WITNESS"
N45°W 4.49' SET REMON NAIL & TAG SW/S 18" ASH
N45°E 38.36' SET REMON NAIL & TAG SE/S 18" MAPLE
N40°W 45.08' FOUNDATION AT SW CORNER OF HOUSE
S45°W 81.02' SET REMON NAIL & TAG SE/S 16" W. OAK

P.A. 345 1990, APPROVED BY LIVINGSTON COUNTY
PFFER GROUP ON 9-1-99, CO. REP JED

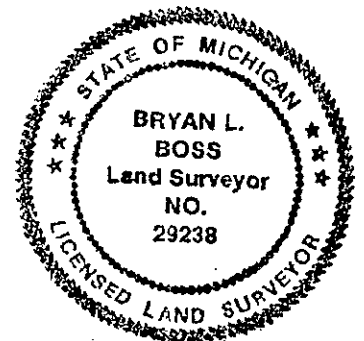

Signed by [Signature] Date NOV 9, 1999
Surveyor's Michigan License No. 29238