

FILED

9/2

JUN 14 8 32 AM '94

LAND CORNER RECORDATION CERTIFICATE  
Filing Requirement of Act 74, Mich. P.A. 1970

NANCY HAVILAND  
REGISTER OF DEEDS  
LIVINGSTON COUNTY, MI  
48643

For corners in  
Livingston  
(County)

	Located In:		Corner Code ##
	1N	5E	
1. Public Land Survey	T _____	R _____	J-12
	T _____	R _____	
	T _____	R _____	
	T _____	R _____	
2. Property Controlling in Section	S _____	T _____	R _____
	S _____	T _____	R _____
3. Miscellaneous Property in Sec.	S _____	T _____	R _____
	S _____	T _____	R _____

L.S.C.#193m  
Register of Deeds Stamp & File Number

4. Lot No. \_\_\_\_\_, Recorded Plat \_\_\_\_\_  
5. Private Claims \_\_\_\_\_

Bryan Boss December 21 93


I, \_\_\_\_\_, in a field survey on \_\_\_\_\_, 19 \_\_\_\_\_, do hereby certify that under requirements of P.A. 74, Michigan P.A. of 1970, the corner points mentioned in lines 1 and 2 above were in conformance with regulations and rules therefore as required in the current manual of survey instructions of the United States Department of the Interior, Bureau of Land Management or by a decree of a Court of Law and/or that the corner points mentioned in lines 3, 4 and 5 above were in conformance with the rules of the Michigan Board of Land Surveyors or by a Decree of a Court of Law, established, re-established, monumented, re-monumented, recovered, found as expressed below:

	A	B	C	D	E	F	G	H	I	J	K	L	M
2	6		5		4		3		2		1		
3													
4	7		8		9		10		11		12		
5													
6	18		17		16		15		14		13		
7													
8	19		20		21		22		23		24		
9													
10	30		29		28		27		26		25		
11													
12	31		32		33		34		35		36		
13													

NOTE: Not more than 4 corners, all in the same town and range, may be recorded on this certificate.

A. Description of original monument and accessories and/or subsequent restoration:  
Not a Government Corner  
Additional information on back.

B. Description of corner evidence found and/or method applied in restoring or reestablishing corner:  
Found 1/2" Rebar at Occupied Fence Intersection  
Theoretical Center of Section is N 51°19'05" E, 7.18 Feet

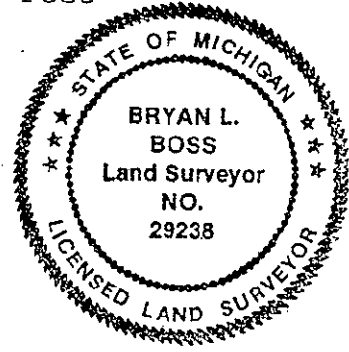

C. Description of monument for corner and accessories established to perpetuate locating the position of the corner:  
Set 1 1/4" x 36" Iron Pipe with Brass Cap  
(Livingston Co. Monument Corner)

North 20.26' Spike 15" Cherry  
N85°E 37.34' Spike 8" Cherry  
South 3.00' Spike 10" Walnut  
S85°W 34.97' Spike 12" Walnut

Approved by Livingston Co.  
Monumentation Peer Group  
on September 15, 1993

Signed by [Signature] Date June 8, 1994  
Surveyor's Michigan License No. 29238

PA. 345 1980, APPROVED BY LIVINGSTON COUNTY  
PEER GROUP ON 15 Sep '93