


MISC. CORNERS*
GREEN OAK TWP.

T1N , R6E

SURVEY &
REMONUMENTATION

MAR 21 1997

COMMISSION

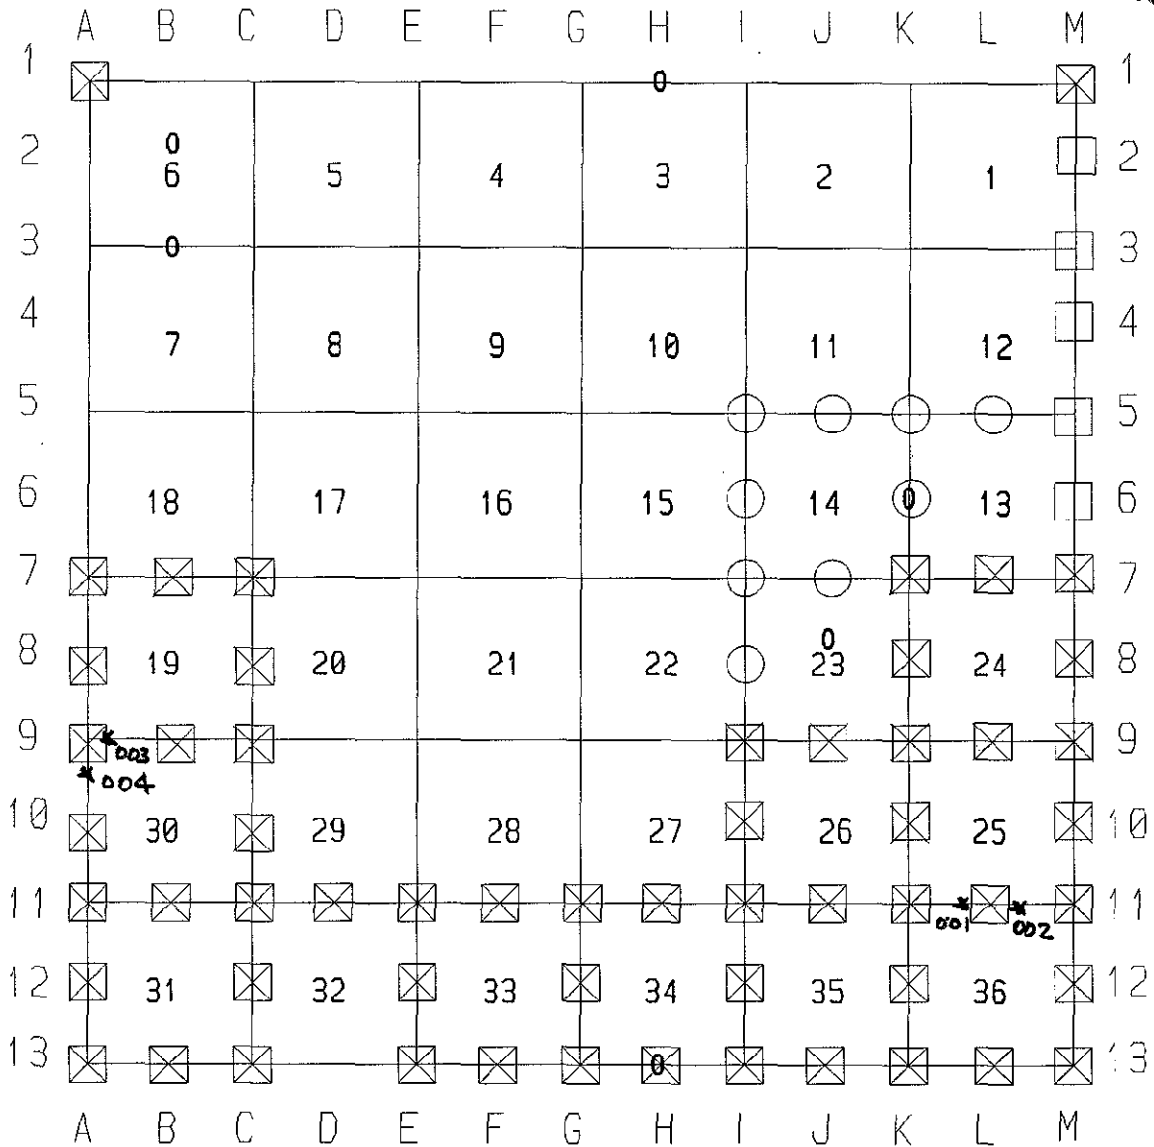

LEGEND

- ☒ CORNERS COMPLETED TO DATE
- 1997 PROPOSED CORNERS
- 1998 PROPOSED CORNERS
- 0 DOUBLE/PROBLEM CORNERS