

9-

LAND CORNER RECORDATION CERTIFICATE
Filing Requirement of Act 74, Mich. P.A. 1970 **FILED**

For Corners in GREEN OAK TWP.

1996 DEC -3 P 3:00K

NANCY HAVILAND
REGISTER OF DEEDS
LIVINGSTON COUNTY, MI.
48843

L.S.C.#623m

REGISTER OF DEEDS STAMP & FILE NUMBER

LIVINGSTON
(COUNTY)

Located In

Corner Code #

1. Public Land Survey

T1N R6E

A-8

T___ R___

T___ R___

T___ R___

2. Property Controlling
in Section

S___ T___ R___

S___ T___ R___

3. Miscellaneous
Property in Sec.

S___ T___ R___

S___ T___ R___

4. Lot No. _____, Recorded Plat _____

5. Private Claims _____

I, BRYAN L. BOSS in a field survey on NOVEMBER 11, 1996, do hereby certify that under requirements of P.A. 74, Michigan P.A. of 1970, the corner points mentioned in lines 1 and 2 above were in conformance with regulations and rules therefore as required in the current manual of survey instructions of the United States Department of the Interior, bureau of Land Management or by a decree of a Court of Law and/or that the corner points mentioned in lines 3, 4 and 5 above were in conformance with the rules of the Michigan Board of Land Surveyors or by a Decree of a Court of Law, established, re-established, monumented, re-monumented, recovered, found as expressed below:

NOTE: Not more than 4 corners, all in the same town and range, may be recorded on this certificate.

	A	B	C	D	E	F	G	H	I	J	K	L	M
2	6	5	4	3	2	1							
3													
4	7	8	9	10	11	12							
5													
6	18	17	16	15	14	13							
7													
8	19	20	21	22	23	24							
9													
10	30	29	28	27	26	25							
11													
12	31	32	33	34	35	36							
13													

A. Description of original monument and accessories and/or subsequent restoration:

BLACK OAK 13" S 12° W .70

BLACK OAK 13" N 30° E .37

B. Description of corner evidence found and/or applied in restoring or reestablishing corner:

(CORNER OBLITERATED)

SPLIT MEASURED DISTANCE BETWEEN APPROVED NORTHWEST CORNER SECTION 19 (A-7)

AND APPROVED SOUTHWEST CORNER SECTION 19 (A-9)

. Description of monument for corner and accessories established to perpetuate location the position of the corner:

SET 1 1/4" X 36" IRON PIPE WITH BRASS CAP STAMPED "LIVINGSTON COUNTY REMONUMENTATION CORNER".

- N 02° E NAIL & TAG EAST SIDE 12" OAK 35.55'
- N 75° E NAIL & TAG NORTH SIDE 16" OAK 10.05'
- S 03° E NAIL & TAG EAST SIDE 14" OAK 30.43'
- N 65° W NAIL & TAG NORTH SIDE 10" WALNUT 26.77'



Signed by Bryan L. Boss
Surveyor's Michigan License No. 29238

Date 11-22-1996

FORM APPROVED BY MICHIGAN STATE BOARD OF LAND SURVEYORS, JAN. 28, 1971
REVISED MAY 14, 1975
REVISED JAN., 1983

CORD

**SUMMARY
A-8**

West 1/4 Corner, Section 19, T1N-R6E, Green Oak Township, Livingston County, Michigan

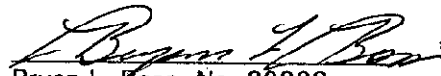
This corner has been obliterated. The only survey showing this corner is found on page 11 of this dossier.

A new North & South fence has been installed 2 feet \pm East of line by Huron-Clinton Metropolitan Authority, and there is no occupation Easterly.

This area is in a heavily wooded area and not conducive for a G.P.S. Station.

The Huron Clinton Metropolitan Authority survey, dated December 1966, measured 1057.70 feet from the centerline of Winans Lake Road to East 1/4 corner of Section 24, Hamburg Township and also measured 475 \pm from Centerline Road to West 1/4 corner of Section 19, Green Oak Township. Government Land Office notes call out 8.735 chains or 576.51 feet. The fall in distance between corners measured 582.7 feet. Huron Clinton Metropolitan Authority survey dated 1958-59 measured 2645 feet from West 1/4 corner of Section 19 to Northwest corner of said section. Whereas Boss Engineering measured 2634.43 feet from the West 1/4 corner of Section to the Northwest corner of said Section.

We recommend setting monument on North and South line between the Southeast corner of Section 24 and the East Corner of Section 24, T1N-R5E, Hamburg Township. We also recommend a split of measured distance 2653.86 feet from the Northwest corner of Section 19, and 2653.86 feet from the Southwest corner of Section 19.


Bryan L. Boss No. 29238

