

1996 NOV 25 A 9:39

LAND CORNER RECORDATION CERTIFICATE
Filing Requirement of Act 74, Mich. P.A. 1970

NANCY HAVILAND
REGISTER OF DEEDS
LIVINGSTON COUNTY, MI.
48843

For corners in

<u>Livingston</u> (County)	Located In:	Corner Code =#
1. Public Land Survey	T <u>1N</u> R <u>6E</u>	<u>A-12</u>
	T _____ R _____	_____
	T _____ R _____	_____
	T _____ R _____	_____
2. Property Controlling In Section	S _____ T _____ R _____	_____
	S _____ T _____ R _____	_____
3. Miscellaneous Property in Sec.	S _____ T _____ R _____	_____
	S _____ T _____ R _____	_____

L.S.C. #609m

Register of Deeds Stamp & File Number

- 4. Lot No. _____, Recorded Plat _____
- 5. Private Claims _____

A	B	C	D	E	F	G	H	I	J	K	L	M
2	6	5	4	3	2	1						
3												
4	7	8	9	10	11	12						
5												
6	18	17	16	15	14	13						
7												
8	19	20	21	22	23	24						
9												
10	30	29	28	27	26	25						
11												
12	31	32	33	34	35	36						
13												

I, Bryan Boss, in a field survey on August 14, 1996, do hereby certify that under requirements of P.A. 74, Michigan P.A. of 1970, the corner points mentioned in lines 1 and 2 above were in conformance with regulations and rules therefore as required in the current manual of survey instructions of the United States Department of the Interior, Bureau of Land Management or by a decree of a Court of Law and/or that the corner points mentioned in lines 3, 4 and 5 above were in conformance with the rules of the Michigan Board of Land Surveyors or by a Decree of a Court of Law; established, re-established, monumented, re-monumented, recovered, found as expressed below:

NOTE: Not more than 4 corners, all in the same town and range, may be recorded on this certificate.


A. Description of original monument and accessories and/or subsequent restoration:
West 1/4 coner section 31 was not set by original survey.

B. Description of corner evidence found and/or method applied in restoring or reestablishing corner:

Found 3/4" iron pipe set by Clay Gordon in 1936.
Recovered and witnessed by Atwell-Hicks in 1977.
Restored by distance to East 1/4 corner of section 36 Hamburg Twp. & witnesses.

C. Description of monument for corner and accessories established to perpetuate locating the position of the corner:

Set 1 1/2" iron pipe 36" in length with brass cap
Livingston County Monument Corner
N 30° E 21.56' nail and tag southeast side 10" hickory
S 85° E 8.85' nail and tag south side 14" hickory
West 6.97' nail and tag south side 6" hickory
S 20° E 14.61 nail and tag west side 14" hickory
North 302.76 feet M-12 east 1/4 corner section 36

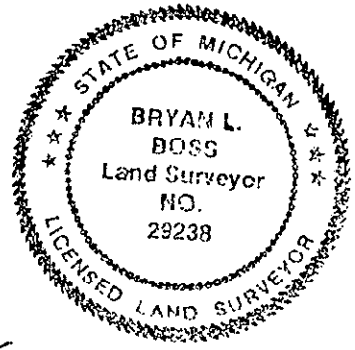

Signed by Bryan L. Boss Date Sept. 26, 1996
Surveyor's Michigan License No. 29238

APPROVED
3/6/96

Summary

A-12

T1N-R6E

West 1/4 corner, Section 31, Green Oak Township, Livingston County, Michigan

G.L.O. surveyed by Alex Holmes in 1816


Found 3/4" pipe 1 foot West and 0.80 feet south of occupied fences east and south of corner. This corner computes 0.23' west of Hamburg Township line (on a straight line between M-12 & M-13).

Witnesses from Atwell-Hicks and Boss Engineering call for 1/2" iron pipe found east 1.7 feet. Atwell-Hicks survey on page 13 this dossier, also explains reason for 1" pipe found 8.18 feet Northwesterly and 5.5 feet west of accepted corner.

The 302.49 ft. distance north to the east 1/4 corner of Section 36, T1N-R5E, concur with the following surveys. Atwell-Hicks in 1977 by John L. Snyder R.L.S. #13357, Roskelly Jekabson R.L.S. #19836 in 1979, Atwell-Hicks in 1980 by Robert J. Jagow R.L.S. #6998 and Boss Engineering in 1987 & 1989.

A-12 is in a fence row and wooded area which creates a difficult G.P.S. Station.

We recommend approval of 3/4" pipe as found and placed on Town Line.

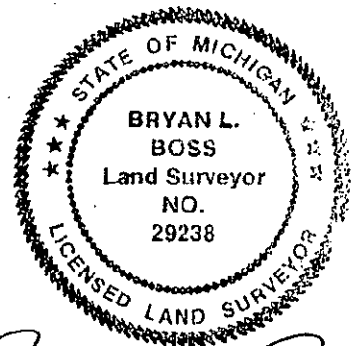

file: SUMMA-12.SAM

A handwritten signature in cursive script that reads "Bryan L. Boss".