

LAND CORNER RECORDATION CERTIFICATE
Filing Requirement of Act 74, Mich. P.A. 1970

9-

For Corners in GREEN OAK TWP.

FILED

<u>LIVINGSTON</u> (COUNTY)	Located In	Corner Code #
1. Public Land Survey	T <u>1</u> N R <u>6</u> E	<u>B-7</u>
	T ___ R ___	_____
	T ___ R ___	_____
	T ___ R ___	_____
2. Property Controlling in Section	S ___ T ___ R ___	_____
	S ___ T ___ R ___	_____
3. Miscellaneous Property in Sec.	S ___ T ___ R ___	_____
	S ___ T ___ R ___	_____

1996 DEC 19 A 11:27

NANCY HAVILAND
REGISTER OF DEEDS
LIVINGSTON COUNTY, MI.
48843

L.S.C.#638m

REGISTER OF DEEDS STAMP & FILE NUMBER

4. Lot No. _____, Recorded Plat _____
5. Private Claims _____

	A	B	C	D	E	F	G	H	I	J	K	L	M
2	6	5	4	3	2	1							
3													
4	7	8	9	10	11	12							
5													
6	18	17	16	15	14	13							
7	19	20	21	22	23	24							
8													
9													
10	30	29	28	27	26	25							
11													
12	31	32	33	34	35	36							
13													

I, BRYAN L. BOSS in a field survey on NOVEMBER 27, 1996, do hereby certify that under requirements of P.A. 74, Michigan P.A. of 1970, the corner points mentioned in lines 1 and 2 above were in conformance with regulations and rules therefore as required in the current manual of survey instructions of the United States Department of the Interior, bureau of Land Management or by a decree of a Court of Law and/or that the corner points mentioned in lines 3, 4 and 5 above were in conformance with the rules of the Michigan Board of Land Surveyors or by a Decree of a Court of Law, established, re-established, monumented, re-monumented, recovered, found as expressed below:

NOTE: Not more than 4 corners, all in the same town and range, may be recorded on this certificate.

A. Description of original monument and accessories and/or subsequent restoration:

WHITE OAK 18" N 88½° W 15.63

B. Description of corner evidence found and/or applied in restoring or reestablishing corner:

- CORNER OBLITERATED -


RESTORED CORNER BY MEANS OF REESTABLISHING CLAY W. GORDON, COUNTY SURVEYOR'S FEBRUARY 1934 AND APRIL, 1939 SURVEYS.
SEE COMPUTATION SHEETS PAGES 16 THROUGH 20.

C. Description of monument for corner and accessories established to perpetuate location the position of the corner:

SET 1¼" X 36" PIPE PIPES WITH BRASS CAP STAMPED "LIVINGSTON COUNTY MONUMENTATION CORNER". ONE WITNESS PER QUADRANT.

- N 45° E 50.00' SET 1¼" X 36" IRON PIPE WITH BRASS CAP STAMPED LIVINGSTON COUNTY REMONUMENTATION WITNESS.
- S 45° E 50.00' SET 1¼" X 36" IRON PIPE WITH BRASS CAP STAMPED LIVINGSTON COUNTY REMONUMENTATION WITNESS.
- S 45° W 50.00' SET 1¼" X 36" IRON PIPE WITH BRASS CAP STAMPED LIVINGSTON COUNTY REMONUMENTATION WITNESS.
- N 45° W 50.00' SET 1¼" X 36" IRON PIPE WITH BRASS CAP STAMPED LIVINGSTON COUNTY REMONUMENTATION WITNESS.

P.A. 345 1990, APPROVED BY LIVINGSTON COUNTY
PEER GROUP ON 7-10-96 CO. REP JED

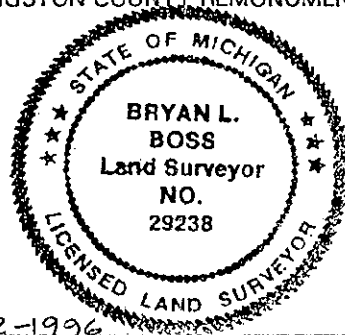

Signed by Bryan L. Boss
Surveyor's Michigan License No. 29238

Date 12-12-1996

SUMMARY

B-7


North 1/4 corner, Section 19, T1N-R6E, Green Oak Township, Livingston County, Michigan

-CORNER OBLITERATED-

To reestablish this corner, Boss Engineering used the February 1934 Survey by Clay Gordon. It denotes ¼ post 3553 feet East of Northwest corner of Section 19, Green Oak Township. This survey also calls for a property line 231 feet East of 1/4 corner in a North-South direction. The property line is also shown on April 29, 1939 survey by Clay Gordon. On March 29, 1960, L.W. Munsell survey traversed Huron River and measured along section lines with the same results as Gordon's survey. Please note that on March 13, 1996, Boss Engineering measured and held Lyle Munsell's distance from the Northwest corner of Section 19 to the North ¼ corner of said Section 19. This point was also set on line between the Northwest corner and Northeast corner of Section 19. A check was made Southerly to the center of the section and found that Boss Engineering measured 2654.73 feet compared to a line 231 feet parallel to the East at 2652.5 feet recorded.

This location is in an open meadow marsh and accessible for G.P.S.

We recommend accepting corner as set and witnessed by pipes - with carsonite markers set in four quadrants at 45° angles and at a distance of 50.00 feet to all witnesses.

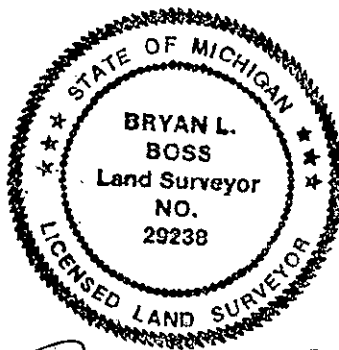

Bryan L. Boss
Bryan L. Boss No. 29238