

1996 NOV 25 A 9 39

LAND CORNER RECORDATION CERTIFICATE  
Filing Requirement of Act 74, Mich. P.A. 1970

NANCY HAVILAND  
REGISTER OF DEEDS  
LIVINGSTON COUNTY, MI.  
48843

For corners in

<u>Livingston</u> (County)	Located in:	Corner Code =#
1. Public Land Survey	T <u>1N</u> R <u>6E</u>	<u>C-10</u>
	T _____ R _____	_____
	T _____ R _____	_____
	T _____ R _____	_____
2. Property Controlling in Section	S _____ T _____ R _____	_____
	S _____ T _____ R _____	_____
3. Miscellaneous Property in Sec.	S _____ T _____ R _____	_____
	S _____ T _____ R _____	_____

L.S.C. #608m  
Register of Deeds Stamp & File Number

4. Lot No. \_\_\_\_\_, Recorded Plat \_\_\_\_\_  
5. Private Claims \_\_\_\_\_

I, Bryan Boss, in a field survey on July 29, 19 96, do hereby certify that under requirements of P.A. 74, Michigan P.A. of 1970, the corner points mentioned in lines 1 and 2 above were in conformance with regulations and rules therefore as required in the current manual of survey instructions of the United States Department of the Interior, Bureau of Land Management or by a decree of a Court of Law and/or that the corner points mentioned in lines 3, 4 and 5 above were in conformance with the rules of the Michigan Board of Land Surveyors or by a Decree of a Court of Law; established, re-established, monumented, re-monumented, recovered, found as expressed below:

A	B	C	D	E	F	G	H	I	J	K	L	M
2	6	5	4	3	2	1						
3												
4	7	8	9	10	11	12						
5												
6	18	17	16	15	14	13						
7												
8	19	20	21	22	23	24						
9												
10	30	29	28	27	26	25						
11												
12	31	32	33	34	35	36						
13												

NOTE: Not more than 4 corners, all in the same town and range, may be recorded on this certificate.

A. Description of original monument and accessories and/or subsequent restoration:

White Oak 11" N 67° E .24  
White Oak 15" N 83° W .34  
  
Set 1/2 mile post.


B. Description of corner evidence found and/or method applied in restoring or reestablishing corner:

Found concrete monument at occupied fence lines North & East of corner

C. Description of monument for corner and accessories established to perpetuate locating the position of the corner:

Set brass cap stamped Livingston County Remonumentation Corner on existing monument.

N 2° E 27.14 Nail & Tag set West side 36" Ash  
N 30° E 13.95 Nail & Tag set Southeast side 14" Twin Hickory  
South 30.41 Nail & Tag set West side Utility Pole  
N 70° W 6.92 Nail & Tag set South side 4" Hickory

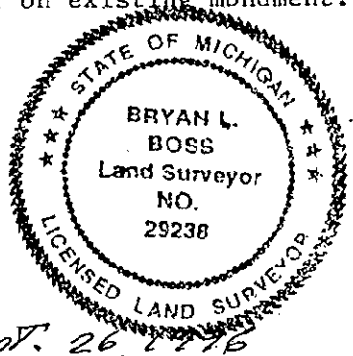

Signed by Bryan L. Boss Date Sept. 26, 1996  
Surveyor's Michigan License No. 29238

P.A. 345 1990, APPROVED BY LIVINGSTON COUNTY  
PEER GROUP ON 7-10-96 CO. REP JED

# SUMMARY

C-10

West ¼ Corner, Section 29, T1N-R6E, Green Oak Township, Livingston County, Michigan.

Found concrete monument at occupied fence lines North and East of corner. Difficult location for G.P.S. This corner was set by Oscar Boss on March 4, 1971 at fence intersection north and east. (See page 12 this dossier). On December 12, 1972, Oscar Boss found that monument had been set at this point and he witnessed same. Oscar Boss also filed an Act 74 certificate on February 8, 1973 in conjunction with prior survey.

Don Ross survey in 1978, measured same as Boss Engineering North and East of West ¼ corner. The 1979 and 1984 surveys by Kostecke and Associates denote measured distance South of West ¼ corner concur with the distances measured by Boss Engineering and Desine Incorporated on later surveys. Witnesses found on 2/29/96 agree with Desine and Kostecke witnesses on page 7 of this dossier.

We therefore recommend accepting concrete monument as found to be the same corner as set by Boss Engineering on 3/4/71.

file: SUMMC-10 SAM

*Bryan L. Boss*

