

**SURVEY &  
REMONUMENTATION**

**FILED**

**LAND CORNER RECORDATION CERTIFICATE**

**APR 28 1995** Filing Requirement of Act 74, Mich. P.A. 1970

**Nov 16 11 02 AM '94**

For corners in

Livingston  
(County)

**COMMISSION:**

Corner Code ≠#

NANCY HAVILAND  
REGISTER OF DEEDS  
LIVINGSTON COUNTY, MI  
48843

1. Public Land Survey	T	<u>1N</u>	R	<u>6E</u>	<u>C-11</u>	
	T	_____	R	_____	_____	
	T	_____	R	_____	_____	
	T	_____	R	_____	_____	
2. Property Controlling in Section	S	_____	T	_____	R	_____
	S	_____	T	_____	R	_____
3. Miscellaneous Property in Sec.	S	_____	T	_____	R	_____
	S	_____	T	_____	R	_____

L.S.C.#295m

Register of Deeds Stamp & File Number

4. Lot No. \_\_\_\_\_, Recorded Plat \_\_\_\_\_  
5. Private Claims \_\_\_\_\_

	A	B	C	D	E	F	G	H	I	J	K	L	M
2	6	5	4	3	2	1							
3													
4	7	8	9	10	11	12							
5													
6	18	17	16	15	14	13							
7													
8	19	20	21	22	23	24							
9													
10	30	29	28	27	26	25							
11													
12	31	32	33	34	35	36							
13													

I, H.L. O'Donnell, in a field survey on August 31, 19 94, do hereby certify that under requirements of P.A. 74, Michigan P.A. of 1970, the corner points mentioned in lines 1 and 2 above were in conformance with regulations and rules therefore as required in the current manual of survey instructions of the United States Department of the Interior, Bureau of Land Management or by a decree of a Court of Law and/or that the corner points mentioned in lines 3, 4 and 5 above were in conformance with the rules of the Michigan Board of Land Surveyors or by a Decree of a Court of Law, established, re-established, monumented, re-monumented, recovered, found as expressed below:

**NOTE:** Not more than 4 corners, all in the same town and range, may be recorded on this certificate.

A. Description of original monument and accessories and/or subsequent restoration:  
GLO notes dated: 12-14-1815  
GLO witnesses: B. Oak 14 in. dia. bears N41 1/2 W 16 lks  
Do. Oak 12 in. dia. bears S44 E 61 lks


Corner Summary on reverse side

B. Description of corner evidence found and/or method applied in restoring or reestablishing corner:  
Found 3/4" iron pipe in centerline of Asphalt Road  
P.K. nail S/S P. pole N75°E 218.15'  
P.K. nail w/tag S. face utility pole Az 80° 218.40'  
SW cor. bldg. Az 60° 265.9'  
Nail in W. face utility pole North 48.96'  
P.K. nail w/tag S. face utility pole Az 283° 276.80'

C. Description of monument for corner and accessories established to perpetuate locating the position of the corner:

C-11, NE cor. Sec. 31, T1N, R6E, Green Oak Township  
Set 1 1/2" x 36" iron pipe in mon. box with L.C.M. brass cap PS #28149  
Set flasher SE face P. pole N80°E 218.07'  
SW brick bldg. cor. N60°E 265.68'  
Set flasher W. face P. pole North 48.86'  
Set flasher S. face P. pole N75°W 276.69'  
Iron rod North 33.00'

Approved by Livingston County Monumentation Peer Group August

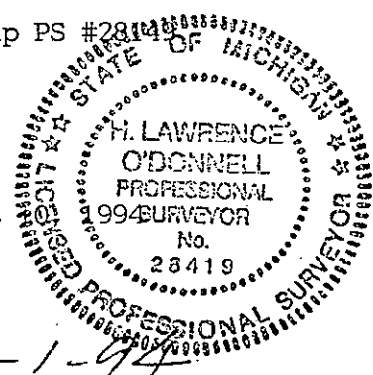

Signed by H. Lawrence O'Donnell Date 11-1-94  
Surveyor's Michigan License No. 28149


CORNER SUMMARY

C-11 NE Corner, Section 31  
Green Oak Township, Livingston County

The oldest known witness is recorded in a sketch by Atwell-Hicks, Inc. as being recorded by the State of Michigan Highway Dept. In 1979 Boss Engineering found a bolt spike in the centerline of the road, record distance from US-23, according to MDSH ROW map. The corner was later referenced by Kostecke in 1979, by Roskelly, Jekabson in 1979, by Boss in 1984, by Donnelly in 1986, by C. Wilson in 1988 and by Boss twice in 1991.

Atwell-Hicks, Inc. found an iron pipe in the centerline of the asphalt road. The witness summary shows a good progression of witnesses since 1979.

I recommend that this found iron pipe be accepted as the NE corner of Section 31 of Green Oak Township.

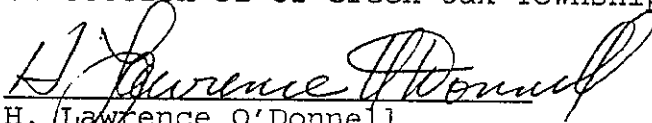  
H. Lawrence O'Donnell