

SURVEY & REMONUMENTATION

FILED

APR 28 1995

LAND CORNER RECORDATION CERTIFICATE

Nov 16 11 02 AM '94

COMMISSION Filing Requirement of Act 74, Mich. P.A. 1970

For corners in

Livingston
(County)

Located In:

Corner Code *≠*

- | | | | |
|---------------------------------------|-------------------------|------|--|
| 1. Public Land Survey | T <u>1N</u> R <u>6E</u> | C-13 | |
| | T _____ R _____ | | |
| | T _____ R _____ | | |
| | T _____ R _____ | | |
| 2. Property Controlling
in Section | S _____ T _____ R _____ | | |
| | S _____ T _____ R _____ | | |
| 3. Miscellaneous
Property in Sec. | S _____ T _____ R _____ | | |
| | S _____ T _____ R _____ | | |

NANCY HAVILAND
REGISTER OF DEEDS
LIVINGSTON COUNTY, MI
48843

L.S.C. #297m

Register of Deeds Stamp & File Number

4. Lot No. _____, Recorded Plat _____
5. Private Claims _____

	A	B	C	D	E	F	G	H	I	J	K	L	M
2	6	5	4	3	2	1							
3													
4	7	8	9	10	11	12							
5													
6	18	17	16	15	14	13							
7													
8	19	20	21	22	23	24							
9													
10	30	29	28	27	26	25							
11													
12	31	32	33	34	35	36							
13													

I, H.L. O'Donnell, in a field survey on August 26, 19 94, do hereby certify that under requirements of P.A. 74, Michigan P.A. of 1970, the corner points mentioned in lines 1 and 2 above were in conformance with regulations and rules therefore as required in the current manual of survey instructions of the United States Department of the Interior, Bureau of Land Management or by a decree of a Court of Law and/or that the corner points mentioned in lines 3, 4 and 5 above were in conformance with the rules of the Michigan Board of Land Surveyors or by a Decree of a Court of Law; established, re-established, monumented, re-monumented, recovered, found as expressed below:

NOTE: Not more than 4 corners, all in the same town and range, may be recorded on this certificate.


- A. Description of original monument and accessories and/or subsequent restoration:
 GLO notes dated: 12-14-1815
 GLO witnesses: No corner made, no timber

Corner Summary on reverse side.

- B. Description of corner evidence found and/or method applied in restoring or reestablishing corner:
 Found 3/4" iron pipe w/W.C.R.C. cap
 E'ly R.O.W. fence (N-s) West 121.6'
 Face conc. light base S 65° E 80.35'
 Face conc. light base N 32° E 165.16'
 Face conc. light base N 40° W 142.58'
 Ctr. 2-4" Cedars N 46° W 104.6'

- C. Description of monument for corner and accessories established to perpetuate locating the position of the corner:
 C-13, SE cor. Sec. 31, T1N, R6E, Green Oak Township.
 Set 1 1/2" X 36" iron pipe with L.C.M. w/ brass cap P.S. #28149
 NW cor. metal light pole base S 80° E 80.84'
 N'ly cor. metal light pole base S 20° W 180.62'
 SE cor. metal light pole base N 50° W 142.93'
 SW cor. metal light pole base N 25° E 165.46'

Approved by Livingston County Monumentation Peer Group August

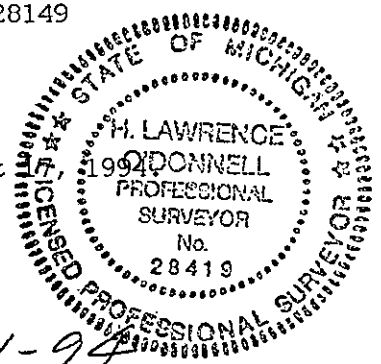

Signed by H. Lawrence O'Donnell Date 11-1-94
 Surveyor's Michigan License No. 28149

P.A. 345 1990, APPROVED BY LIVINGSTON COUNTY
 PEER GROUP ON 17 Aug 94 CO. REP [Signature]

