

**SURVEY &  
REMONUMENTATION**

**FILED**

**APR 28 1995 LAND CORNER RECORDATION CERTIFICATE**  
Filing Requirement of Act 74, Mich. P.A. 1970

**Nov 16 11 02 AM '94**

For corners in

**COMMISSION**

**NANCY HAVILAND  
REGISTER OF DEEDS  
LIVINGSTON COUNTY, MI  
48843**

<u>Livingston</u> (County)	Located In:	Corner Code =#
1. Public Land Survey	T <u>1N</u> R <u>6E</u>	<u>D-11</u>
	T _____ R _____	_____
	T _____ R _____	_____
	T _____ R _____	_____
2. Property Controlling in Section	S _____ T _____ R _____	_____
	S _____ T _____ R _____	_____
3. Miscellaneous Property in Sec.	S _____ T _____ R _____	_____
	S _____ T _____ R _____	_____
4. Lot No. _____, Recorded Plat _____		
5. Private Claims _____		

L.S.C. #298m  
Register of Deeds Stamp & File Number

I, H.L. O'Donnell, in a field survey on August 30, 19 94, do hereby certify that under requirements of P.A. 74, Michigan P.A. of 1970, the corner points mentioned in lines 1 and 2 above were in conformance with regulations and rules therefore as required in the current manual of survey instructions of the United States Department of the Interior, Bureau of Land Management or by a decree of a Court of Law and/or that the corner points mentioned in lines 3, 4 and 5 above were in conformance with the rules of the Michigan Board of Land Surveyors or by a Decree of a Court of Law; established, re-established, monumented, re-monumented, recovered, found as expressed below:

A	B	C	D	E	F	G	H	I	J	K	L	M
2	6	5	4	3	2	1						
3												
4	7	8	9	10	11	12						
5												
6	10	17	16	15	14	13						
7												
8	19	20	21	22	23	24						
9												
10	30	29	28	27	26	25						
11												
12	31	32	33	34	35	36						
13												

**NOTE: Not more than 4 corners, all in the same town and range, may be recorded on this certificate.**


- A. Description of original monument and accessories and/or subsequent restoration:  
GLO notes dated: 12-14-1815  
GLO witnesses: B. Oak 12 in. dia. bears N28 1/2 E 35 lks  
W. Oak 10 in. dia. bears S75 W 30 lks

Corner Summary on reverse side

- B. Description of corner evidence found and/or method applied in restoring or reestablishing corner:  
Found 1/2" iron rod  
SW cor. bridge abut. N80°E 271.50'  
Painted centerline of pavement North 15.00'  
P.K. nail top of guard rail post S75°E 124.43'  
P.K. nail E. side wood post S5°W 38.31'

- C. Description of monument for corner and accessories established to perpetuate locating the position of the corner:  
D-11 N 1/4 cor. Sec. 32, T1N, R6E, Green Oak Township  
Set 1 1/2" x 36" iron pipe in mon. box with L.C.M. brass cap #28149  
SW cor. bridge abut. S88°E 242.20'  
NW cor. bridge abut. N80°E 271.50'  
Set flasher on guard rail post S75°E 124.43'  
Set flasher E. face wood post S5°W 38.31'

Approved by Livingston County Monumentation Peer Group August

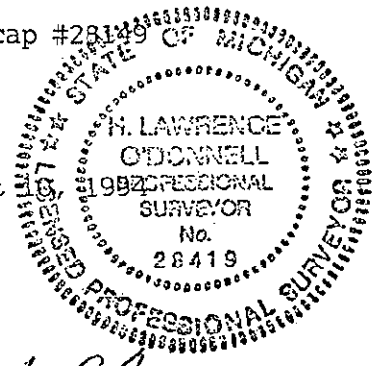

Surveyed by H. Lawrence O'Donnell Date 11-1-94  
Surveyor's Michigan License No. 28149

10' 15' 30" 1/4"

## CORNER SUMMARY

D-11, N 1/4 Corner, Section 32  
Green Oak Township, Livingston County

The oldest known witness is by M.W. Bullock in 1874, recorded in the old county surveyor's records, which show the corner 4.25 chains West of a northerly running road. In 1921 a crew for H.H. Atwell took parole evidence from local residence as to the location of the N 1/4. The parole evidence agrees with the witnesses of M.W. bullock. The crew recorded that they were unable to locate the N 1/4 corner. The N 1/4 corner is not referenced again until 1979 in a survey by Roskelly, Jekabson. The corner was later referenced by Donnelly in 1986, by Michigan Engineering and surveying group in 1989 and by Boss in 1991.

Atwell-Hicks, Inc. found a 1/2" iron rod at the N 1/4 corner position that is 0.96' East of equal distance between the NW and NE corners of Section 32. Also the corner is 0.48' N of the straight line between the NW and NE corners of Section 32. No other lines were found after a search of the area. Possible GPS position.

I recommend that this found 1/2" iron rod be accepted as the N 1/4 corner of Section 32.

  
H. Lawrence O'Donnell