

RECORDED

MAR 17 2000

FILED

SECTION

LAND CORNER RECORDATION CERTIFICATE
Filing Requirement of Act 74, Mich. P.A. 1970

1999 NOV 22 A 11: 10

For corners in
LIVINGSTON

(County)

Located in: GREEN OAK Corner Code #

9

NANCY HAVILAND
REGISTER OF DEEDS
LIVINGSTON COUNTY, MI.
48843

1. Public Land Survey	T 1N	R 6E	E-5
	T	R	
	T	R	
	T	R	
2. Property Controlling in Section	S	T	R
	S	T	R
3. Miscellaneous Property in Sec.	S	T	R
	S	T	R

LSC# 1138m

Register of Deeds Stamp and File Number

- 4. Lot No. _____, Recorded Plat _____
- 5. Private Claims _____

I, Bryan L. Boss, in a field survey on OCT 12, 1999
do hereby certify that under requirements of P.A. 74, Michigan P.A. of 1970, the corner points mentioned
in lines 1 and 2 above were in conformance with regulations and rules therefor as required in the
current manual of survey instructions of the United States Department of the Interior, Bureau of Land
Management or by a decree of a Court of Law and/or that the corner points mentioned in lines 3, 4 and 5
above were in conformance with the rules of the Michigan Board of Land Surveyors or by a Decree of a
Court of Law; established, re-established, monumented, re-monumented, recovered, found as
expressed below.

NOTE: Not more than 4 corners, all in the same town and range, may be recorded on this certificate.

	A	B	C	D	E	F	G	H	I	J	K	L	M
2	6		5		4		3		2		1		
3													
4	7		8		9		10		11		12		
5													
6	18		17		16		15		14		13		
7													
8	19		20		21		22		23		24		
9													
10	30		29		28		27		26		25		
11													
12	31		32		33		34		35		36		
13													

A. Description of original monument and accessories and/or subsequent restoration:


SET POST
22" WHITE OAK N56°W 14L
13" WHITE OAK S86°E 17L

B. Description of corner evidence found and/or method applied in restoring or reestablishing corner:

FOUND CONCRETE MONUMENT

C. Description of monument for corner and accessories established to perpetuate locating the position of the corner:

SET BRASS CAP STAMPED "LIVINGSTON COUNTY
REMONUMENTATION CORNER" ON EXISTING
CONCRETE MONUMENT
DUE NORTH 9.92' SET REMON N/T E SIDE 12"
CEDAR
S80°E 10.40' SET REMON N/T N SIDE 14" CEDAR
S45°E 9.0' SET REMON N/T W SIDE 12" OAK
DUE SOUTH 23.85' SET REMON N/T E SIDE 20"
CHERRY

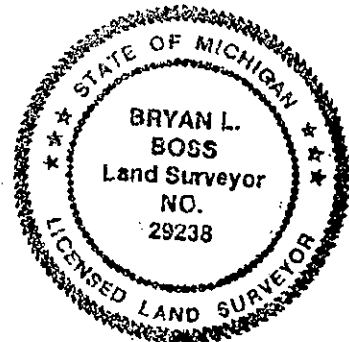

PA. 345 1990, APPROVED BY LIVINGSTON COUNTY

PEER GROUP ON 7-21-99 CO. REP JED

Signed by Bryan L. Boss

Date NOV 3, 1999

Surveyor's Michigan License No. 29238