

MAR 17 2000

REFERENCE ID: 25

FILED

SECTION

LAND CORNER RECORDATION CERTIFICATE
Filing Requirement of Act 74, Mich. P.A. 1970

1999 NOV 22 A 11: 10

For corners in
LIVINGSTON

(County)

Located in: GREEN OAK Corner Code #

9

NANCY HAVILAND
REGISTER OF DEEDS
LIVINGSTON COUNTY, MI.
48843

- 1. Public Land Survey T IN R 6E E-8
T R
T R
T R
- 2. Property Controlling S T R
in Section S T R
- 3. Miscellaneous S T R
Property in Sec. S T R

LSC# 1141m

Register of Deeds Stamp and File Number

- 4. Lot No. _____, Recorded Plat _____
- 5. Private Claims _____

I, Bryan L. Boss, in a field survey on 10-12-99
do hereby certify that under requirements of P.A. 74, Michigan P.A. of 1970, the corner points mentioned
in lines 1 and 2 above were in conformance with regulations and rules therefor as required in the
current manual of survey instructions of the United States Department of the Interior, Bureau of Land
Management or by a decree of a Court of Law and/or that the corner points mentioned in lines 3, 4 and 5
above were in conformance with the rules of the Michigan Board of Land Surveyors or by a Decree of a
Court of Law, established, re-established, monumented, re-monumented, recovered, found as
expressed below.

NOTE: Not more than 4 corners, all in the same town and range, may be recorded
on this certificate.

	A	B	C	D	E	F	G	H	I	J	K	L	M
2	6	5	4	3	2	1							
3													
4	7	8	9	10	11	12							
5													
6	18	17	16	15	14	13							
7													
8	19	20	21	22	23	24							
9													
10	30	29	28	27	26	25							
11													
12	31	32	33	34	35	36							
13													

A. Description of original monument and accessories and/or subsequent restoration:

SET POST
S. 16 1/2° E 53 1/2 L 10" BLACK OAK
N. 17°W 49L 10" BLACK OAK


B. Description of corner evidence found and/or method applied in restoring or reestablishing corner:

FOUND BOSS IRON ROD AND CAP

C. Description of monument for corner and accessories established to perpetuate locating the position of the corner:

SET 1 1/4" X 36" PIPE WITH BRASS CAP
STAMPED "LIVINGSTON COUNTY
REMONUMENTATION CORNER"

N40°W 24.22' SET REMON N/T S. SIDE 14" OAK
S30°E 23.46 SET REMON N/T W. SIDE 10" OAK
N05° E 11.82' SET REMON N/T E. SIDE 14" OAK
N50° E 33.38' SET REMON N/T W. SIDE 14" OAK

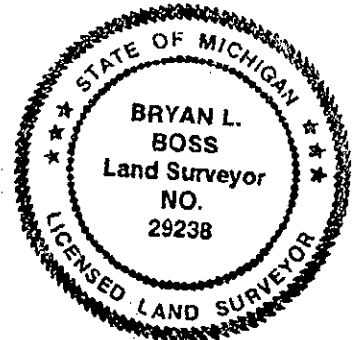

P.A. 345 1990, APPROVED BY LIVINGSTON COUNTY

PEER GROUP ON 9-1-99 CO. REP JED

Signed by Bryan L. Boss

Date NOV. 9, 1999

Surveyor's Michigan License No. 29238