

# SURVEY & REMONUMENTATION

FILED

APR 28 1995  
LAND CORNER RECORDATION CERTIFICATE  
COMMISSION (Being Requirement of Act 74, Mich. P.A. 1970)

Nov 16 11 02 AM '94

NANCY HAVILAND  
REGISTER OF DEEDS  
LIVINGSTON COUNTY, MI  
48843

For corners in

<u>Livingston</u> <small>(County)</small>	Located In:	Corner Code =#	
1. Public Land Survey	T <u>1N</u> R <u>6E</u>	<u>E-11</u>	
	T _____ R _____	_____	
	T _____ R _____	_____	
	T _____ R _____	_____	
2. Property Controlling in Section	S _____ T _____ R _____	_____	
	S _____ T _____ R _____	_____	
3. Miscellaneous Property in Sec.	S _____ T _____ R _____	_____	
	S _____ T _____ R _____	_____	
4. Lot No. _____, Recorded Plat _____			
5. Private Claims _____			

L.S.C.#299m

Register of Deeds Stamp & File Number

I, H.L. O'Donnell, in a field survey on September 8, 19 94,

do hereby certify that under requirements of P.A. 74, Michigan P.A. of 1970, the corner points mentioned in lines 1 and 2 above were in conformance with regulations and rules therefore as required in the current manual of survey instructions of the United States Department of the Interior, Bureau of Land Management or by a decree of a Court of Law and/or that the corner points mentioned in lines 3, 4 and 5 above were in conformance with the rules of the Michigan Board of Land Surveyors or by a Decree of a Court of Law; established, re-established, monumented, re-monumented, recovered, found as expressed below:

NOTE: Not more than 4 corners, all in the same town and range, may be recorded on this certificate.

A. Description of original monument and accessories and/or subsequent restoration:

GLO notes dated: 12-14-1815

GLO witnesses: B. Oak 12 in. dia. bears N 80 E 57 lks

Do. 11 in. dia. bears N 32 W 1.05 lks

Corner Summary on reverse side

B. Description of corner evidence found and/or method applied in restoring or reestablishing corner:

Found 1" iron pipe

F. nail N. side 20" Elm S45°W 14.73'

F. nail W. side 10" Oak S10°W 22.49'

F. nail E. side 10" Oak South 36.90'

F. nail E. side 10" Oak N40°W 17.35'

F. nail N. side 15" Oak S60°E 26.32'

C. Description of monument for corner and accessories established to perpetuate locating the position of the corner:

E-11, NE cor. Sec. 32, T1N, R6E, Green Oak Township

Set 1 1/2" x 36" iron pipe with L.C.M. brass cap PS #28149 at w'ly base of conc. fence post cor.


Set remon cap N. face 20" Oak S45°W 14.73'

Set remon cap E. face 10" Oak South 36.90'

Set remon cap E. face 10" Oak N40°W 17.35'

Set remon cap N. side 16" Oak S60°E 26.32'

Approved by Livingston County Monumentation Peer Group August 10, 1994

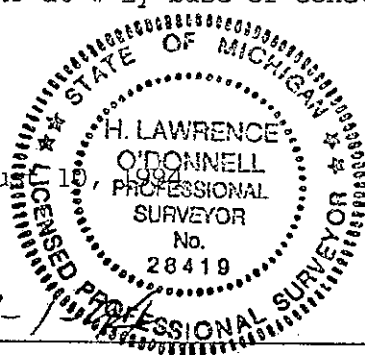


Signed by H. Lawrence O'Donnell Date 11-1

Surveyor's Michigan License No. 28149

FORM APPROVED BY MICHIGAN STATE BOARD OF LAND SURVEYORS, JAN. 28, 1971

REVISED MAY 14, 1975  
REVISED JAN., 1983

P.A. 345 1990, APPROVED BY LIVINGSTON COUNTY  
PEER GROUP ON 10 Aug 94 CO. REP [Signature]

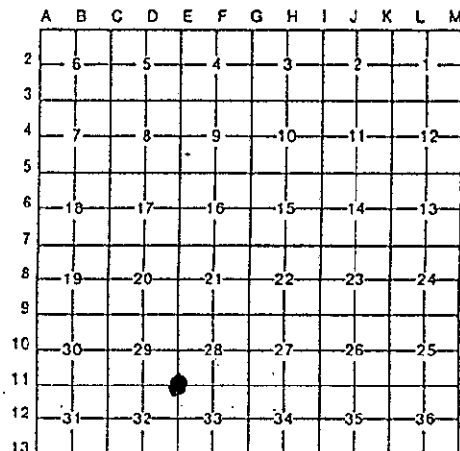

07.117

10' 11' 20" 11' 40"

CORNER SUMMARY

E-11, NE corner, Section 32  
Green Oak Township, Livingston County

The oldest known witness is 1919 by Cole when he found a spike and replaced it with a 1" iron pipe. The corner was later witnessed by Atwell-Hicks, Inc. in 1924, by Atwell-Hicks, Inc. in 1957, by the State of Michigan Highway Dept. in their 1971 witness cards, by Boss in 1973, by Michigan Eng. & Surveying Group in 1989 and by Boss in 1991.

Atwell-Hicks, Inc. found a 1" iron pipe in 1994 which meet well with previously recorded witnesses. No other irons were found after a search of the area.

I recommend that this found iron pipe be accepted as the N.E. corner of Section 32 of Green Oak Township.

  
H. Lawrence O'Donnell