

# SURVEY & REMONUMENTATION

APR 28 1995

## LAND CORNER RECORDATION CERTIFICATE COMMISSION

Filing Requirement of Act 74, Mich. P.A. 1970

**FILED**  
Nov 16 11:02 AM '94

NANCY HAVILAND  
REGISTER OF DEEDS  
LIVINGSTON COUNTY, MI  
48843

or corners in

<u>Livingston</u> <small>(County)</small>	Located In:	Corner Code =/:	
Public Land Survey	T <u>1N</u> R <u>6E</u>	<u>E-12</u>	
Accessory Corner for	T _____ R _____	_____	
	T _____ R _____	_____	
	T _____ R _____	_____	
Property Controlling	S _____ T _____ R _____	_____	
in Section	S _____ T _____ R _____	_____	
Miscellaneous	S _____ T _____ R _____	_____	
Property in Sec.	S _____ T _____ R _____	_____	

L.S.C. #300m  
Register of Deeds Stamp & File Number

Lot No. \_\_\_\_\_, Recorded Plat \_\_\_\_\_  
Private Claims \_\_\_\_\_

	A	B	C	D	E	F	G	H	I	J	K	L	M
2	6	5	4	3	2	1							
3													
4	7	8	9	10	11	12							
5													
6	18	17	16	15	14	13							
7													
8	19	20	21	22	23	24							
9													
10	30	29	28	27	26	25							
11													
12	31	32	33	34	35	36							
13													

H.L. O'Donnell, in a field survey on November 14, 19 94,

hereby certify that under requirements of P.A. 74, Michigan P.A. of 1970, the corner points mentioned in lines 1 and 2 above were in conformance with regulations and rules theretofore as required in the current manual of survey instructions of the United States Department of the Interior, Bureau of Land Management or by a decree of a Court of Law and/or that the corner points mentioned in lines 3, 4 and 5 above were in conformance with the rules of the Michigan Board of Land Surveyors or by a Decree of a Court of Law; established, re-established, monumented, re-monumented, recovered, found as expressed below:


NOTE: Not more than 4 corners, all in the same town and range, may be recorded on this certificate.

Description of original monument and accessories and/or subsequent restoration:  
GLO notes dated: 12-14-1815  
GLO witnesses: Qr. sec. post in lake

Corner summary on reverse side

Description of corner evidence found and/or method applied in restoring or reestablishing corner:  
Accessory corner established 100'± of the east shore of Whitmore Lake and on the E-W 1/4 line as monumented, between the center of Section 33 and the southeast corner of Mar-Bru Subdivision as recorded on Liber 10, page 41, Livingston County Records.

Description of monument for corner and accessories established to perpetuate locating the position of the corner:  
E-12 E 1/4 cor. Sec. 33, T1N, R6E, Green Oak Township  
Set 1"x36" iron pipe with LCM brass cap PS #28419  
Set flasher and nail N. face MBT pole N50° E 4.62'  
Set flasher and nail S. face 30" Willow S70°W 18.83'  
Set flasher and nail E. face 26" ash S05°W 14.25'  
SW cor. of SW stone pillar Hse #11509 E. Shore Dr. S85°E 39.09'  
Fence line east 0.8'

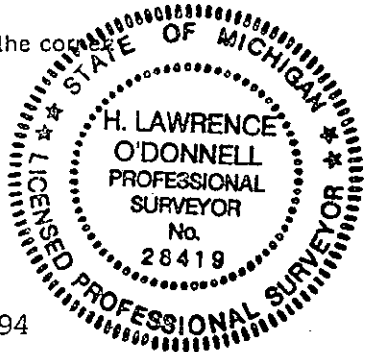

Approved by Livingston County Monumentation Peer Group, September 14, 1994

Signed by H. Lawrence O'Donnell Date 11-15-94  
Surveyor's Michigan License No. 28419

P.A. 345 1990, APPROVED BY LIVINGSTON COUNTY  
PEER GROUP ON 14 Sep. 94 CO. REP [Signature]

CR 117

CORNER SUMMARY

E-12, W 1/4 corner, Section 33  
Green Oak Township, Livingston County

The G.L.O. notes of 1815 record the W 1/4 corner of Section 33 as being in the lake and does not indicate that a post was set.

The only reference to the center being set is in a 1922 survey by Atwell-Hicks, Inc. which records a 10.71 foot long iron pipe being set in 5.6 feet of water.

I recommend the acceptance of an iron pipe, being set within 200.00 feet of the shore of Whitmore lake and on the line from the E 1/4 corner of said Section 33 and the center of said Section 33 as set by Roskelly, Jekabson & Assoc. Job #85-11-20. Said iron pipe to reference the line to the W 1/4 corner of Section 33 of Green Oak Township.

  
H. Lawrence O'Donnell