

MAR 17 2000

FILED

SECTION

LAND CORNER RECORDATION CERTIFICATE
Filing Requirement of Act 74, Mich. P.A. 1970

1999 NOV 22 A 11:11

For corners in
LIVINGSTON
(County)

Located in: GREEN OAK Corner Code #

9

NANCY HAVILAND
REGISTER OF DEEDS
LIVINGSTON COUNTY, MI.
48843

- 1. Public Land Survey T IN R 6E F-7
- T R
- T R
- T R
- 2. Property Controlling S T R
- in Section S T R
- 3. Miscellaneous S T R
- Property in Sec. S T R

LSC# 1144m

Register of Deeds Stamp and File Number

- 4. Lot No. _____, Recorded Plat _____
- 5. Private Claims _____

I, Bryan L. Boss, In a field survey on 10-20-99
do hereby certify that under requirements of P.A. 74, Michigan P.A. of 1970, the corner points mentioned in lines 1 and 2 above were in conformance with regulations and rules therefor as required in the current manual of survey instructions of the United States Department of the Interior, Bureau of Land Management or by a decree of a Court of Law and/or that the corner points mentioned in lines 3,4 and 5 above were in conformance with the rules of the Michigan Board of Land Surveyors or by a Decree of a Court of Law; established, re-established, monumented, re-monumented, recovered, found as expressed below.

NOTE: Not more than 4 corners, all in the same town and range, may be recorded on this certificate.

	A	B	C	D	E	F	G	H	I	J	K	L	M
2	6	5	4	3	2	1							
3													
4	7	8	9	10	11	12							
5													
6	18	17	16	15	14	13							
7													
8	19	20	21	22	23	24							
9													
10	30	29	28	27	26	25							
11													
12	31	32	33	34	35	36							
13													

A. Description of original monument and accessories and/or subsequent restoration:


SET POST AT AVERAGE DISTANCE IN SWAMP
N.38 1/2°E. 1.27 CH. 23" WHITE OAK

B. Description of corner evidence found and/or method applied in restoring or reestablishing corner:

FOUND BOSS IRON IN EAST-WEST FENCE IN SMALL SWAMP 49.24'
WEST OF A BOSS IRON FOUND IN EW & SOUTH FENCE
INTERSECTION.

C. Description of monument for corner and accessories established to perpetuate locating the position of the corner:

SET 1 1/4" X 3/8" PIPE WITH BRASS CAP STAMPED
"LIVINGSTON COUNTY REMONUMENTATION
CORNER"
DUE NORTH 92.86' SET REMON. NAIL AND TAG
SE/SIDE 20" OAK
N 50°E 68.04' SET REMON.NAIL AND TAG S/SIDE
22" OAK
DUE SOUTH 99.80' SET REMON. NAIL AND TAG
W/SIDE 18" PINE
S 20°W 46.80' SET REMON. NAIL AND TAG E/SIDE
22" ASH

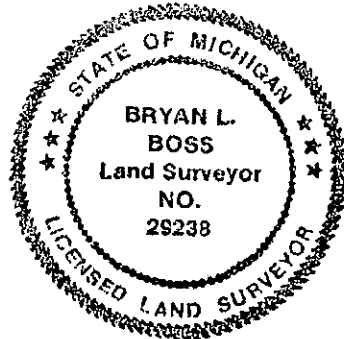

P.A. 345 1990, APPROVED BY LIVINGSTON COUNTY
PEER GROUP ON 9-1-99, CO. REP JED

Signed by [Signature] Date NOV. 9, 1999
Surveyor's Michigan License No. 29238