

**SURVEY &
REMONUMENTATION**

FILED

APR 28 1995 LAND CORNER RECORDATION CERTIFICATE
Filing Requirement of Act 74, Mich. P.A. 1970

Nov 16 11 02 AM '94

COMMISSION

NANCY HAVILAND
REGISTER OF DEEDS
LIVINGSTON COUNTY, MI
48843

For corners in

Livingston
(County)

Located In:

Corner Code ##

- | | | |
|------------------------------------|-------------------------|-------------|
| 1. Public Land Survey | T <u>1N</u> R <u>6E</u> | <u>F-11</u> |
| | T _____ R _____ | _____ |
| | T _____ R _____ | _____ |
| | T _____ R _____ | _____ |
| 2. Property Controlling in Section | S _____ T _____ R _____ | _____ |
| | S _____ T _____ R _____ | _____ |
| 3. Miscellaneous Property in Sec. | S _____ T _____ R _____ | _____ |
| | S _____ T _____ R _____ | _____ |

L.S.C. #302m

Register of Deeds Stamp & File Number

4. Lot No. _____, Recorded Plat _____
5. Private Claims _____

	A	B	C	D	E	F	G	H	I	J	K	L	M
2	6		5		4		3		2		1		
3													
4	7		8		9		10		11		12		
5													
6	18		17		16		15		14		13		
7													
8	19		20		21		22		23		24		
9													
10	30		29		28		27		26		25		
11													
12	31		32		33		34		35		36		
13													

I, H.L. O'Donnell, in a field survey on August 31, 19 94, do hereby certify that under requirements of P.A. 74, Michigan P.A. of 1970, the corner points mentioned in lines 1 and 2 above were in conformance with regulations and rules therefore as required in the current manual of survey instructions of the United States Department of the Interior, Bureau of Land Management or by a decree of a Court of Law and/or that the corner points mentioned in lines 3, 4 and 5 above were in conformance with the rules of the Michigan Board of Land Surveyors or by a Decree of a Court of Law; established, re-established, monumented, re-monumented, recovered, found as expressed below:


NOTE: Not more than 4 corners, all in the same town and range, may be recorded on this certificate.

- A. Description of original monument and accessories and/or subsequent restoration:
GLO notes dated: 12-14-1815
GLO witnesses: B. Oak 18 in. dia. bears N48E 46 lks
R. Oak 14 in. dia. bears S80W 25 lks

Corner Summary on reverse side

- B. Description of corner evidence found and/or method applied in restoring or reestablishing corner:
Found 1/2" iron rod at Centerline Road
On range fence line North (falling down)
F. nail SE face of 20" W. Oak N45°E 50.23'
Centerline of sq. cor. post North 32.0'
Centerline of 10" Ash N10°E 48.6'
SE cor. of garage N15°W 173.66'
Nail in W. face twin 15" Hickory N5°E 74.18'
Centerline of stump N65°E 89.7'

- C. Description of monument for corner and accessories established to perpetuate locating the position of the corner:
F-11, N 1/4 cor. Sec. 33, T1N, R6E, Green Oak Township
Set 1 1/2" x 36" iron pipe in mon. box with L.C.M. brass cap PS #28149
Set flasher SE face 20" Oak N45°E 50.23'
Set flasher W face 10" Ash N10°E 48.60'
Set flasher W face 15" Hickory N5°E 74.18'
SE brick garage cor. N15°W 173.66'
Approved by Livingston County Monumentation Peer Group August 10, 1994

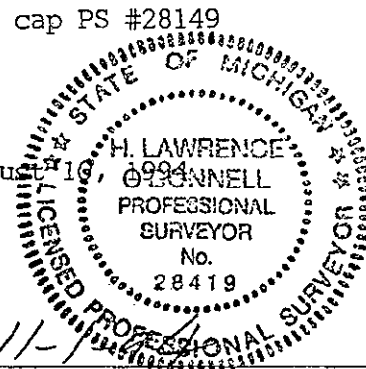

Signed by H. Lawrence O'Donnell Date 11-1

Surveyor's Michigan License No. 28149

FORM APPROVED BY MICHIGAN STATE BOARD OF LAND SURVEYORS, JAN. 28, 1971
REVISED MAY 14, 1975
REVISED JAN., 1983

PA. 345 1990, APPROVED BY LIVINGSTON COUNTY
PEER GROUP ON 10/22/94 CO. REP R.A.H.

FILED

NOV 16 11 05 AM 1984

CORNER SUMMARY

F-11, N 1/4 corner, Section 33
Green Oak Township, Livingston County

The oldest known witness is by Atwell-Hicks, Inc. in 1889 which lists only one witness and gives no reference to what was found. The corner was later witnessed by Atwell-Hicks, Inc. in 1914 and 1958, by Munsell in 1963, by Boss in 1971, 1973 and twice in 1981, in Michigan Highway designs in 1983, by Garlock in 1984, by Roskelly-Jekabson in 1985, by Boss in 1986, by Garlock in 1987 and by Boss twice in 1989.

Atwell-Hicks, Inc. found a 1/2 " iron rod in 1994 in the centerline of the black topped road of M-36. There is a fence on line of the rod running north. No other irons were found after a search of the area.

I recommend that this found iron rod be accepted as the N 1/4 corner of Section 33 of Green Oak Township.


H. Lawrence O'Donnell