

**SURVEY &
REMONUMENTATION**

FILED

APR 28 1995

LAND CORNER RECORDATION CERTIFICATE

Nov 16 11 02 AM '94

COMMISSION Filing Requirement of Act 74, Mich. P.A. 1970

NANCY HAVILAND
REGISTER OF DEEDS
LIVINGSTON COUNTY, MI
48843

or corners in

Livingston
(County)

Located In:

Corner Code =#

Public Land Survey	T	1N	R	6E	F-13
Accessory Corners for	T		R		
	T		R		
	T		R		
Property Controlling	S		T	R	
in Section	S		T	R	
Miscellaneous	S		T	R	
Property in Sec.	S		T	R	

L.S.C.#303m

Register of Deeds Stamp & File Number

Lot No. _____, Recorded Plat _____
Private Claims _____

	A	B	C	D	E	F	G	H	I	J	K	L	M
2	6		5		4		3		2		1		
3													
4	7		8		9		10		11		12		
5													
6	18		17		16		15		14		13		
7													
8	19		20		21		22		23		24		
9													
10	30		29		28		27		26		25		
11													
12	31		32		33		34		35		36		
13													

H.L.O'Donnell, In a field survey on November 13, 19 94

do hereby certify that under requirements of P.A. 74, Michigan P.A. of 1970, the corner points mentioned in lines 1 and 2 above were in conformance with regulations and rules therefore as required in the current manual of survey instructions of the United States Department of the Interior, Bureau of Land Management or by a decree of a Court of Law and/or that the corner points mentioned in lines 3, 4 and 5 above were in conformance with the rules of the Michigan Board of Land Surveyors or by a Decree of a Court of Law; established, re-established, monumented, re-monumented, recovered, found as expressed below:

NOTE: Not more than 4 corners, all in the same town and range, may be recorded on this certificate.

Description of original monument and accessories and/or subsequent restoration:
GLO notes dated: December 14, 1815
GLO witnesses: Qr. section corner in lake

Corner summary on reverse side

Description of corner evidence found and/or method applied in restoring or reestablishing corner:
Accessory corners were set on the east side of Mud Lake a distance of 1110.74 feet from the SE corner of Section 33 and on the west side of Mud Lake a distance of 1575.08 feet from the SW corner of Section 33. The accessory corners were set on a straight line between the SE and SW corners of Section 33.



Description of monument for corner and accessories established to perpetuate locating the position of the corner:

F-13, S 1/4 cor. Sec. 33, T1N, R6E, Green Oak Township reference corners.

West side of Mud Lake

- Set 1"x36" iron pipe with L.C.R. Brass cap #28419
- SE cor. sextagon brick bldg N50°W 94.15'
- Set flasher N.face 14" Cherry North 47.77'
- Set flasher E.face 12" Elm S10°W 17.61'
- Set flasher N.face 8" Elm S70°E 15.84'
- E-W fence line North 1.6'

East side of Mud Lake

- Set 1"x36" iron pipe with L.C.R. Brass cap #28419
- Nail 10" Walnut S45°W 4.57'
- Nail 14" Oak N75°E 25.61'
- Nail 22" Cottonwood N75°W 26.13'
- Nail 12" Birch S10°E 33.14'

Note: Set point @ W'ly edge of wetlands

Approved by Livingston County Monumentation Peer Group, September 14, 1994

Signed by H. Lawrence O'Donnell Date 11-15-94

Surveyor's Michigan License No. 28419


12' 11" x 11" 1/2"

CORNER SUMMARY

F-13, S 1/4 corner, Section 33
Green Oak Township, Livingston County

This corner was not set during the original survey by the G.L.O. The records show a lake with a swamp all around which they traversed but did not set meander corners for.

I recommend that an iron pipe be set within 200.00 feet of the east and west shores of said lake and on the line between the previously accepted SW and SE corners of said Section 33 of Green Oak Township. Said iron pipes to reference the south line of said Section 33 of Green Oak Township.

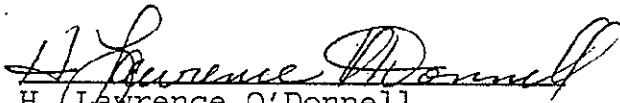

H. Lawrence O'Donnell