

MAR 17 2000

FILED

SECTION

LAND CORNER RECORDATION CERTIFICATE  
Filing Requirement of Act 74, Mich. P.A. 1970

1999 NOV 22 A 11: 11

For corners in  
LIVINGSTON  
(County)

Located in: GREEN OAK Corner Code #

9

NANCY HAVILAND  
REGISTER OF DEEDS  
LIVINGSTON COUNTY, MI.  
48843

1. Public Land Survey	T	IN	R	6E	G-5
	T		R		
	T		R		
	T		R		
2. Property Controlling in Section	S	T	R		
	S	T	R		
3. Miscellaneous Property in Sec.	S	T	R		
	S	T	R		

LSC# 1146m

Register of Deeds Stamp and File Number

- 4. Lot No. \_\_\_\_\_, Recorded Plat \_\_\_\_\_
- 5. Private Claims \_\_\_\_\_

I, Bryan L. Boss, in a field survey on OCTOBER 15, 1999  
do hereby certify that under requirements of P.A. 74, Michigan P.A. of 1970, the corner points mentioned in lines 1 and 2 above were in conformance with regulations and rules therefor as required in the current manual of survey instructions of the United States Department of the Interior, Bureau of Land Management or by a decree of a Court of Law and/or that the corner points mentioned in lines 3, 4 and 5 above were in conformance with the rules of the Michigan Board of Land Surveyors or by a Decree of a Court of Law; established, re-established, monumented, re-monumented, recovered, found as expressed below.

NOTE: Not more than 4 corners, all in the same town and range, may be recorded on this certificate.

A	B	C	D	E	F	G	H	I	J	K	L	M
2	5	5	4	3	2	1						
3												
4	7	8	9	10	11	12						
5												
6	18	17	16	15	14	13						
7												
8	19	20	21	22	23	24						
9												
10	30	29	28	27	26	25						
11												
12	31	32	33	34	35	36						
13												

A. Description of original monument and accessories and/or subsequent restoration:

SET POST  
10" WHITE OAK S. 4"E 78L (51.5')  
16" WHITE OAK N. 2 1/2"W 56 L (37.0')


B. Description of corner evidence found and/or method applied in restoring or reestablishing corner:

FOUND D.N.R. CONC. MONUMENT WITH ALUMINUM CAP.

C. Description of monument for corner and accessories established to perpetuate locating the position of the corner:

FOUND D.N. R. CONCRETE MONUMENT WITH ALUMINUM CAP  
N75°E 40.56' SET 1 1/4" X 36" PIPE WITH BRASS CAP STAMPED "LIVINGSTON COUNTY REMONUMENTATION WITNESS"  
S20°E 68.61 SET 1 1/4" X 36" PIPE WITH BRASS CAP STAMPED "LIVINGSTON COUNTY REMONUMENTATION WITNESS".  
S75°W 54.15' SET 1 1/4" X 36" PIPE WITH BRASS CAP STAMPED "LIVINGSTON COUNTY REMONUMENTATION WITNESS".

N40°W 160.00' SET REMON NAIL & TAG N/S TWIN 10" ELM

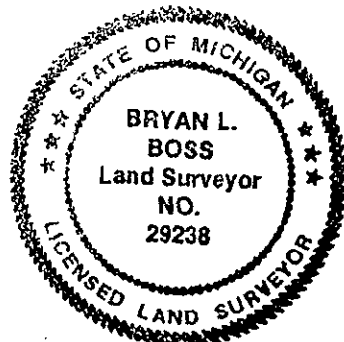

PA. 345 1990, APPROVED BY LIVINGSTON COUNTY  
PEER GROUP ON 7-21-99 CO. REP. JED

Signed by Bryan L. Boss Date NOV 9, 1999  
Surveyor's Michigan License No. 29238