

MAR 17 2000

FILED

SECTION

LAND CORNER RECORDATION CERTIFICATE

Filing Requirement of Act 74, Mich. P.A. 1970 NOV 22 A 11:11

For corners in

LIVINGSTON

(County)

Located in: GREEN OAK Corner Code #

9

NANCY HAVILAND
REGISTER OF DEEDS
LIVINGSTON COUNTY, MI.
48843

- 1. Public Land Survey T IN R 6E G-6
- T R
- T R
- T R
- 2. Property Controlling S T R
- in Section S T R
- 3. Miscellaneous S T R
- Property in Sec. S T R


LSC# 1147m

Register of Deeds Stamp and File Number

- 4. Lot No. , Recorded Plat
- 5. Private Claims

I, Bryan L. Boss, in a field survey on 10-12-99

do hereby certify that under requirements of P.A. 74, Michigan P.A. of 1970, the corner points mentioned in lines 1 and 2 above were in conformance with regulations and rules therefor as required in the current manual of survey instructions of the United States Department of the Interior, Bureau of Land Management or by a decree of a Court of Law and/or that the corner points mentioned in lines 3, 4 and 5 above were in conformance with the rules of the Michigan Board of Land Surveyors or by a Decree of a Court of Law; established, re-established, monumented, re-monumented, recovered, found as expressed below.

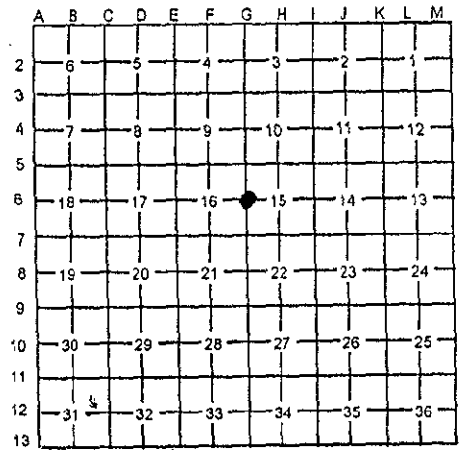

NOTE: Not more than 4 corners, all in the same town and range, may be recorded on this certificate.

A. Description of original monument and accessories and/or subsequent restoration:


SET POST
N. 47°E 40L 10" BLACK OAK
S. 86°W 45L 15" WHITE OAK

B. Description of corner evidence found and/or method applied in restoring or reestablishing corner:

FOUND D.N.R. CONCRETE. MONUMENT

C. Description of monument for corner and accessories established to perpetuate locating the position of the corner:

FOUND DNR CONCRETE MONUMENT
S.80°W 11.58' SET REMON. N/T S.SIDE 12" MAPLE
N.30°W 16.98' SET REMON. N/T E.SIDE 25" OAK
S.05°E. 1.80' SET REMON. N/T E. SIDE 6" MAPLE
N.80°E. 33.60' SET REMON N/T 14" CHERRY

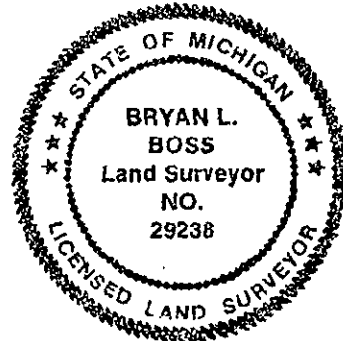

PA. 248 1999, APPROVED BY LIVINGSTON COUNTY
PEER GROUP ON 7-21-99, CO. REP JED

Signed by [Signature]
Surveyor's Michigan License No. 29238

Date NOV 9, 1999