

**SURVEY &
REMONUMENTATION**

FILED

APR 28 1996 AND CORNER RECORDATION CERTIFICATE

Filing Requirement of Act 74, Mich. P.A. 1970

Nov 16 11:02 AM '94

COMMISSION

NANCY HAVILAND
REGISTER OF DEEDS
LIVINGSTON COUNTY, MI
48843

For corners in Livingston (County) Located In: _____ Corner Code =# _____

1. Public Land Survey	T <u>1N</u> R <u>6E</u>	<u>G-11</u>
	T _____ R _____	_____
	T _____ R _____	_____
	T _____ R _____	_____
2. Property Controlling in Section	S _____ T _____ R _____	_____
	S _____ T _____ R _____	_____
3. Miscellaneous Property in Sec.	S _____ T _____ R _____	_____
	S _____ T _____ R _____	_____

L.S.C. #304m

Register of Deeds Stamp & File Number

4. Lot No. _____, Recorded Plat _____
5. Private Claims _____

A	B	C	D	E	F	G	H	I	J	K	L	M
2	6	5	4	3	2	1						
3												
4	7	8	9	10	11	12						
5												
6	18	17	16	15	14	13						
7												
8	19	20	21	22	23	24						
9												
10	30	29	28	27	26	25						
11												
12	31	32	33	34	35	36						
13												

I, H.L. O'Donnell, in a field survey on August 30, 19 94, do hereby certify that under requirements of P.A. 74, Michigan P.A. of 1970, the corner points mentioned in lines 1 and 2 above were in conformance with regulations and rules therefor as required in the current manual of survey instructions of the United States Department of the Interior, Bureau of Land Management or by a decree of a Court of Law and/or that the corner points mentioned in lines 3, 4 and 5 above were in conformance with the rules of the Michigan Board of Land Surveyors or by a Decree of a Court of Law; established, re-established, monumented, re-monumented, recovered, found as expressed below:

NOTE: Not more than 4 corners, all in the same town and range, may be recorded on this certificate.

A. Description of original monument and accessories and/or subsequent restoration:
GLO notes dated: 12-14-1815
GLO witnesses: W. Oak 12 in. dia. bears N33°W 30 lks
Do. 30 in. dia. bears N60°E 55 lks


Corner Summary on reverse side

B. Description of corner evidence found and/or method applied in restoring or reestablishing corner:
Found 1/2" rod at centerline of road
Nail in 36" B/ Walnut N30°W 58.25'
16 d. nail in N. face D.E. pole N70°E 67.73'
P.K. nail in N. face D.E. pole N70°E 67.39'
Centerline D.E. pole N60°W 50.3'
P.K. nail in SE face utility pole S50°W 58.98'
P.K. nail in NE face utility pole S50°W 58.59'
F. nail in W. face 30" Maple S21°E 97.42'
5/8" rerod S45°E 46.61'

C. Description of monument for corner and accessories established to perpetuate locating the position of the corner:

G-11 NE cor. Sec. 33, T1N, R6E, Green Oak Township
Set 1 1/2" x 36" iron pipe in mon. box with L.C.M. brass cap PS #28149
Set flasher SW face 36" Walnut N30°W 58.25'
Set flasher N face P. pole N70°E 67.73'
Set flasher SE face P. pole S50°W 58.98'
Set flasher W face 30" Cherry S20°E 97.42'
5/8" rerod S45°E 46.61'

Approved by Livingston County Monumentation Peer Group August 10,

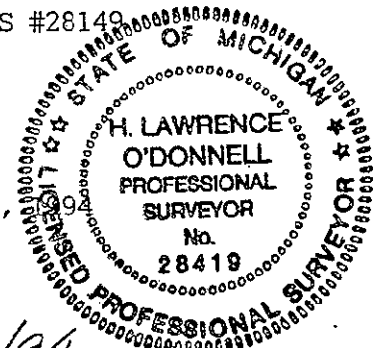

Signed by H. Lawrence O'Donnell Date 10/27/94
Surveyor's Michigan License No. 28149

FORM APPROVED BY MICHIGAN STATE BOARD OF LAND SURVEYORS, JAN. 28, 1971
REVISED MAY 14, 1975
REVISED JAN., 1983

PA. 345 1980, APPROVED BY LIVINGSTON COUNTY
PEER GROUP ON 10/27/94 CO. REP [Signature]

CORNER SUMMARY

G-11, NE corner, Section 33
Green Oak Township, Livingston County

The oldest known witness is by Atwell-Hicks, Inc. in 1903 where only one witness was recorded and gives no reference to what was found. The corner was later referenced by Gordon in 1947, by Munsell in 1954 which describes the corner as being set by Cole, by Munsell in 1956, by Gordon in 1957, by Atwell-Hicks, Inc. in 1958, by Munsell in 1963, by Garlock in 1971, by Munsell-Garlock in 1974, in the Green Oak Township grid book in 1974, by Munsell & Garlock in 1977, by Boss in 1978 and 1981, by Michigan Highway Designs in 1983, by Garlock in 1984, by Boss in 1984 and 1989, by Michigan Eng. & Surv. Group in 1990 and by Roskelly-Jekabson in 1992.

Atwell-Hicks, Inc. found a 1/2" iron rod in 1994 located in the centerline of the road. No other irons were found after a search of the area.

I recommend that this found iron rod be accepted as the NE corner of Section 33 of Green Oak Township.


H. Lawrence O'Donnell