

**SURVEY &
REMONUMENTATION**

FILED

APR 28 1995

LAND CORNER RECORDATION CERTIFICATE

COMMISSION Filing Requirement of Act 74, Mich. P.A. 1970

Nov 16 11 02 AM '94

NANCY HAVILAND
REGISTER OF DEEDS
LIVINGSTON COUNTY, MI
48843

L.S.C.#306m

Register of Deeds Stamp & File Number

For corners in

Livingston
(County)

Located In:

Corner Code --#

- | | | |
|---------------------------------------|-------------------------|-------------|
| 1. Public Land Survey | T <u>1N</u> R <u>6E</u> | <u>G-13</u> |
| | T _____ R _____ | _____ |
| | T _____ R _____ | _____ |
| | T _____ R _____ | _____ |
| 2. Property Controlling
in Section | S _____ T _____ R _____ | _____ |
| | S _____ T _____ R _____ | _____ |
| 3. Miscellaneous
Property in Sec. | S _____ T _____ R _____ | _____ |
| | S _____ T _____ R _____ | _____ |

4. Lot No. _____, Recorded Plat _____
5. Private Claims _____

	A	B	C	D	E	F	G	H	I	J	K	L	M
2	6	5	4	3	2	1							
3													
4	7	8	9	10	11	12							
5													
6	13	17	16	15	14	13							
7													
8	19	20	21	22	23	24							
9													
10	30	29	28	27	26	25							
11													
12	31	32	33	34	35	36							
13													

I, H.L. O'Donnell, in a field survey on August 26, 19 94, do hereby certify that under requirements of P.A. 74, Michigan P.A. of 1970, the corner points mentioned in lines 1 and 2 above were in conformance with regulations and rules therefore as required in the current manual of survey instructions of the United States Department of the Interior, Bureau of Land Management or by a decree of a Court of Law and/or that the corner points mentioned in lines 3, 4 and 5 above were in conformance with the rules of the Michigan Board of Land Surveyors or by a Decree of a Court of Law; established, re-established, monumented, re-monumented, recovered, found as expressed below:

NOTE: Not more than 4 corners, all in the same town and range, may be recorded on this certificate.

A. Description of original monument and accessories and/or subsequent restoration:

GLO notes dated: 12-14-1815
GLO witnesses: W. Oak 18 in. dia. bears S29 W 26 links
W. Oak 18 in. dia. bears N79 W 23 links

Corner Summary on reverse side.


B. Description of corner evidence found and/or method applied in restoring or reestablishing corner:

Found 3/8" iron rod w/cap
Nail W. face 24" & 30" Twin Oak S10°E 28.35'
Nail S. face 14" Hickory N80°E 70.25'
Nail W. face 14" Hickory N10°E 77.28'
Nail S.E. face power pole N30°E 51.94'

C. Description of monument for corner and accessories established to perpetuate locating the position of the corner:

G-13 SE cor. Sec. 33, T1N, R6E, Green Oak Township
Found 3/4" iron pipe in conc. 2.0' below gravel surface
Set 1 1/2" x 12" break-away iron pipe over conc. w/L.C.M. brass cap PS #28149
Set flasher W. face Twin 24"-30" Oak S10°E 28.35'
Set flasher W. face 14" Hickory N10°E 77.28'
Set flasher S.E. face P. pole N30°E 51.94'
Set flasher S. face 14" Hickory N80°E 70.25'
NE cor. Sec. 4 Northfield Twp. West 99.04'

Approved by Livingston County Monumentation Peer Group August 15, 1994

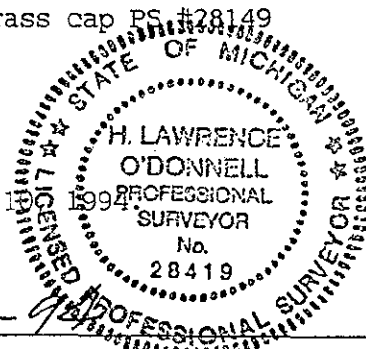

Signed by H. Lawrence O'Donnell Date 11-1-94
Surveyor's Michigan License No. 28149

CORNER SUMMARY

G-13, S.E. corner, Section 33
Green Oak Township, Livingston County

The oldest known witness is by Atwell-Hicks, Inc. in 1914 where only one witness was recorded and gives no reference to what was found. A section sketch of 1958 references witnesses by W.J. Armstrong in 1936 where he found a square iron bar, stake and stones, and replaced with an iron pipe, stones and brick. Atwell-Hicks, Inc. found a conc. monument in 1958 and raised it with a 1/2" iron pipe and spike. The corner was later referenced by C. Wilson in 1972, by Washtenaw Engineering in 1974, by Jekabson in 1974, by Roskelly, Jekabson in 1978, by C. Wilson in 1984, in a witness grid book with no date, by Roskelly-Jekabson in 1985 and by Ambit in 1992.

Atwell-Hicks, Inc. found a 3/8" iron rod with a cap in 1994 which agrees with two witnesses of 1936. No other irons were found after a search of the area.

I recommend that this found iron rod be accepted as the S.E. corner of Section 33 of Green Oak Township.


H. Lawrence O'Donnell