

FEB 25 1999

9-

SECTION

FILED

LAND CORNER RECORDATION CERTIFICATE
Filing Requirement of Act 74, Mich. P.A. 1970

For corners in

Livingston
(County)

Located In:

Corner Code //

1998 OCT 27 P 2: 22

NANCY HAVILAND
REGISTER OF DEEDS
LIVINGSTON COUNTY, MI.
48843

LSC969M

Register of Deeds Stamp & File Number

- 1. Public Land Survey T 1N R 6E I-6
 T _____ R _____
 T _____ R _____
 T _____ R _____
- 2. Property Controlling S _____ T _____ R _____
 in Section S _____ T _____ R _____
- 3. Miscellaneous S _____ T _____ R _____
 Property in Sec. S _____ T _____ R _____

- 4. Lot No. _____, Recorded Plat _____
- 5. Private Claims _____

I, Bryan L. BOSS, in a field survey Oct. 6, 19 98, do hereby certify that under requirements of P.A. 74, Michigan P.A. of 1970, the corner points mentioned in lines 1 and 2 above were in conformance with regulations and rules thereof as required in the current manual of survey instructions of the United States Department of the Interior, Bureau of Land Management or by a decree of a Court of Law and/or that the corner points mentioned in lines 3, 4 and 5 above were in conformance with the rules of the Michigan Board of Land Surveyors or by a Decree of a Court of Law; established, re-established, monumented, re-monumented, recovered, found as expressed below:

NOTE: Not more than 4 corners, all in the same town and range, may be recorded on this certificate.

A. Description of original monument and accessories and/or subsequent restoration:

Set post 1823
 Oak 10" S 52 E 38 L
 Oak 13" S 25 W 24 L


B. Description of corner evidence found and/or method applied in restoring or reestablishing corner:

Found 1" iron rod at Southside fence post
 N 45 W Norhteast side of a 16" Hickory 20.13
 Southeast side of a 24" White Oak 19.35
 S 45 W Southeast side of 14" Hickory 19.27

PA. 345 1890, APPROVED BY LIVINGSTON COUNTY
 PEER GROUP ON 9-16-98 CO. REP JED

C. Description of monument for corner and accessories established to perpetuate locating the position of the corner:

Set 1 1/4" iron pipe 36" long with Brass cap stamped "Livingston
 County Monumentation Corner
 East set Remon N/T South side 30" White Oak 15.27
 N 45 W set Remon N/T Northeast 20.13 16" Hickory
 South set Remon Eastside 24" White Oak 19.35
 S 45 W Set Remon N/T Southeast side 19.27 14" Hickory

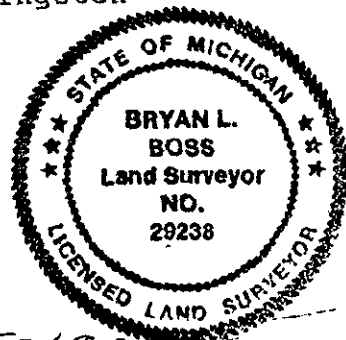

Signed by Bryan L. Boss
 Surveyor's Michigan License No. 29238

Date 10-15-1998

