

FEB 25 1999

9-

FILED

SECTION

LAND CORNER RECORDATION CERTIFICATE
Filing Requirement of Act 74, Mich. P.A. 1970

1998 DEC 11 P 12:44

For corners in

LIVINGSTON
(County)

Located In: GREEN OAK TOWNSHIP
Corner Code // I - 7

- 1. Public Land Survey
T 1N R 6E
- 2. Property Controlling in Section
S T R
- 3. Miscellaneous Property in Sec.
S T R

NANCY HAVILAND
REGISTER OF DEEDS
LIVINGSTON COUNTY, MI.
48843

L.S.C. #988m

Register of Deeds Stamp & File Number

- 4. Lot No. _____, Recorded Plat _____
- 5. Private Claims _____

	A	B	C	D	E	F	G	H	I	J	K	L	M
2	6	5	4	3	2	1							
3													
4	7	8	9	10	11	12							
5													
6	18	17	16	15	14	13							
7													
8	19	20	21	22	23	24							
9													
10	30	29	28	27	26	25							
11													
12	31	32	33	34	35	36							
13													

I, **BRYAN L. BOSS**, in a field survey on **OCTOBER 6**, 19 **98**, do hereby certify that under requirements of P.A. 74, Michigan P.A. of 1970, the corner points mentioned in lines 1 and 2 above were in conformance with regulations and rules therefore as required in the current manual of survey instructions of the United States Department of the Interior, Bureau of Land Management or by a decree of a Court of Law and/or that the corner points mentioned in lines 3, 4 and 5 above were in conformance with the rules of the Michigan Board of Land Surveyors or by a Decree of a Court of Law, established, re-established, monumented, re-monumented, recovered, found as expressed below:


NOTE: Not more than 4 corners, all in the same town and range, may be recorded on this certificate.

A. Description of original monument and accessories and/or subsequent restoration:
BLACK OAK 10" N 52 1/2 E 24
WHITE OAK 8" S 87 W 63
SET POST

B. Description of corner evidence found and/or method applied in restoring or reestablishing corner:
FOUND CONCRETE MONUMENT

C. Description of monument for corner and accessories established to perpetuate locating the position of the corner:
SET 1 1/4" x 36" IRON PIPE WITH BRASS CAP STAMPED
"LIVINGSTON COUNTY MONUMENTATION CORNER.
N 60° E 25.16 NAIL & TAG NW TWIN 22" OAK
SOUTH 22.80 SET NAIL & TAG WESTSIDE 16" OAK
S 30° W 4.94 SET NAIL & TAG EASTSIDE 22" HICKORY
WEST 22.31 SET NAIL & TAG SOUTHSIDE 8" HICKORY

P.A. 345 1980, APPROVED BY LIVINGSTON COUNTY
PEER GROUP ON 9-2-98 CO. REP JED

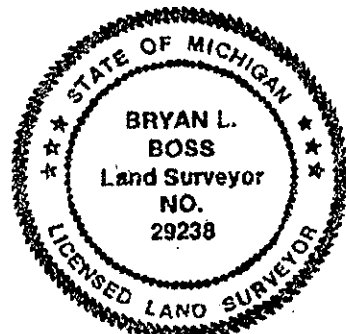

Signed by Bryan L. Boss
Surveyor's Michigan License No. 29238

Date Dec. 11, 1998