

FILED

9-

LAND CORNER RECORDATION CERTIFICATE

Filing Requirement of Act 74, Mich. P.A. 1970

~~Oct 16 4 13 PM '95~~

For corners in Livingston

NANCY HAVILAND  
REGISTER OF DEEDS  
LIVINGSTON COUNTY, MI  
43843

(County)	Located In:	Corner Code #/
1. Public Land Survey	T 1N R 6E	1-9
	T R	
	T R	
	T R	
2. Property Controlling in Section	S T R	
	S T R	
3. Miscellaneous Property in Sec.	S T R	
	S T R	

Nov 16 2 27 PM '95

NANCY HAVILAND  
REGISTER OF DEEDS  
LIVINGSTON COUNTY, MI  
43843

L.S.C. #1742 522m

Register of Deeds Stamp & File Number

- 4. Lot No. \_\_\_\_\_, Recorded Plat \_\_\_\_\_
- 5. Private Claims \_\_\_\_\_

	A	B	C	D	E	F	G	H	I	J	K	L	M
2	6	5	4	3	2	1							
3													
4	7	8	9	10	11	12							
5													
6	18	17	16	15	14	13							
7													
8	19	20	21	22	23	24							
9													
10	30	29	28	27	26	25							
11													
12	31	32	33	34	35	36							
13													

I, Bryan Boss, in a field survey on 10-14, 1995, do hereby certify that under requirements of P.A. 74, Michigan P.A. of 1970, the corner points mentioned in lines 1 and 2 above were in conformance with regulations and rules therefore as required in the current manual of survey instructions of the United States Department of the Interior, Bureau of Land Management or by a decree of a Court of Law and/or that the corner points mentioned in lines 3, 4 and 5 above were in conformance with the rules of the Michigan Board of Land Surveyors or by a Decree of a Court of Law; established, re-established, monumented, re-monumented, recovered, found as expressed below:

NOTE: Not more than 4 corners, all in the same town and range, may be recorded on this certificate.

A. Description of original monument and accessories and/or subsequent restoration:

White Oak 11" S 55° E 25 links  
 White Oak 10" N 79° W 37 links  
 Set by Alex Holmes in 1816.

B. Description of corner evidence found and/or method applied in restoring or reestablishing corner:


Re-established northwest corner of Section 26  
 By means of double proportionate method.  
 Solution found in textbook by John G. McEntyre entitled "Land Survey Systems" on pages 227-228.

REMONUMENTATION

NOV 27 1995  
COMMISSION

C. Description of monument for corner and accessories established to perpetuate locating the position of the corner:

Set monument box and set 30" pipe with brass cap in concrete road 6.1 feet north of centerline.  
 66.0 feet N 20° E southwest corner of building #11953  
 169.47' S 85° E top/center of monitoring well box  
 120.87' S 25° W northeast corner building #11936  
 38.67' N 65° W top/center hydrant

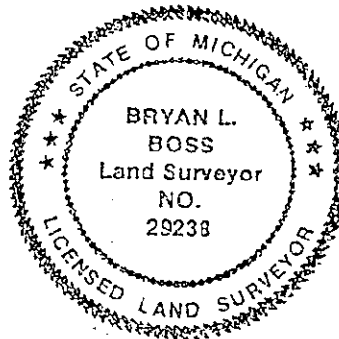

Signed by [Signature] Date Oct. 16 1995  
 Surveyor's Michigan License No. 29238

SUMMARY

I-9

NORTHWEST CORNER, SECTION 26, T1N-R5E, GREEN OAK TOWNSHIP, LIVINGSTON COUNTY, MICHIGAN

-LOST CORNER-

Original corner set by Alex Holmes in 1816. Witnessed in 1823 by United States Government. 1935 survey by Clay Gordon finds U.S. measurement of 2653.2 feet crossed out and distance of 2685 feet measured by Gordon from Section corner Westerly to South 1/4 corner of Section 22. This corner falls in construction area of Centennial Farm Cooperative Phase I Incorporated, (an apartment complex established prior to site condominium developments). The area is open for G.P.S.

In January of 1995, Boss Engineering re-established the northwest corner of Section 26 by means of double proportionated method. The measured location falls 16 feet short of Clay Gordon and 16 feet longer than the original survey by Holmes to the South 1/4 corner of Section 22. The north and south split is  $6\frac{1}{2} \pm$  short of Clay Gordons measurement of 1935. And the North 1/8 line of Section 26 fits occupation by 0.40 feet at a distance of 1325.71 feet split.

We recommend placement of corner as set by Boss Engineering on 1-3-95.

SUMMI-9

