

LAND CORNER RECORDATION CERTIFICATE
Filing Requirement of Act 74, Mich. P.A. 1970

For corners in

<u>Livingston</u> <small>(County)</small>	Located In:	Corner Code #/
1. Public Land Survey.	T1N R 6E	T-13
	T R	
	T R	
	T R	
2. Property Controlling in Section	S T R	
	S T R	
3. Miscellaneous Property in Sec.	S T R	
	S T R	

FILED
 Dec 27 11 14 AM '93
 NANCY HAYLAND
 REGISTER OF DEEDS
 LIVINGSTON COUNTY, MI
 48843
 L.S.C. # 98m
 Register of Deeds Stamp & File Number

4. Lot No. _____, Recorded Plat _____
 5. Private Claims _____

	A	B	C	D	E	F	G	H	I	J	K	L	M
2	6		5		4		3		2				
3													
4	7		8		9		10		11		12		
5													
6	18		17		16		15		14		13		
7													
8	19		20		21		22		23		24		
9													
10	30		29		28		27		26		25		
11													
12	31		32		33		34		35		36		
13													

H. Lawrence O'Donnell survey on December 23, 1993, do hereby certify that under requirements of P.A. 74, Michigan P.A. of 1970, the corner points mentioned in lines 1 and 2 above were in conformance with regulations and rules therefore as required in the current manual of survey instructions of the United States Department of the Interior, Bureau of Land Management or by a decree of a Court of Law and/or that the corner points mentioned in lines 3, 4 and 5 above were in conformance with the rules of the Michigan Board of Land Surveyors or by a Decree of a Court of Law; established, re-established, monumented, re-monumented, recovered, found as expressed below:

NOTE: Not more than 4 corners, all in the same town and range, may be recorded on this certificate.

A. Description of original monument and accessories and/or subsequent restoration:

GLO Survey in November 1815 by Joseph Wampler
 Set post common to Secs 34 & 35

Aspen 12 N32W 5 lks
 Hickory 8 S54E 8 lks

(Additional historical data on back of sheet)

B. Description of corner evidence found and/or method applied in restoring or reestablishing corner:


Found 1½" Iron Pipe
 Wm. Armstrong found a pipe in 1936 none of witnesses set at that time were found. 1 witness from Washtenaw Engineering 1975 survey found and 1 witness from Roskelly & Jekabson 1979 survey was found.

C. Description of monument for corner and accessories established to perpetuate locating the position of the corner:

Set Brass Cap in 1½" Iron Pipe

6" Triple Walnut	N35°E	34.88'	to nail w/flasher
8" Elm	South	13.40'	to nail w/flasher
8" Elm	S20°W	16.86'	to nail w/flasher
6" Ash	N30°W	31.57'	to nail w/flasher

NW Corner Section 2, T1S, R6E, West 175.22

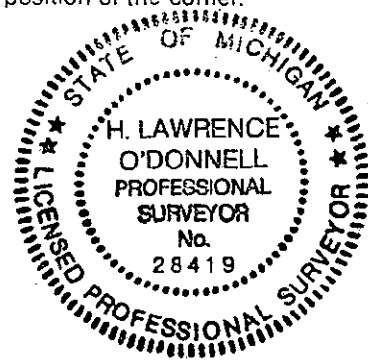

Signed by H. Lawrence O'Donnell Date December 23, 1993
 Surveyor's Michigan License No. 28419

Civil Engineering • Surveying
Planning • Environmental Services

A T W E L L - H I C K S , I N C .

540 Avis Drive
P.O. Box 2981
Ann Arbor, Michigan 48106
313 994 4000 • FAX: 313 994 1599

RESEARCH SUMMARY

I-13 SW Corner Section 35, T1N, R6E

Found 1-1/2" Iron pipe at the SW corner location.

Original GLO survey notes reference post set common to Section 34 & 35 from which an Aspen 12 in dia bears N32W 5 lks and a Hickory 8 in dia bears S 54 E 8 lks.

Earliest found reference to the corner was 4-2-36 when Wm. Armstrong found an iron (size nor type described).

Corner is referenced in a 1968 survey by Washtenaw Engineering; 1975 survey by W.E. Co.; 1976 survey by Boss Engineering; 1979 survey by Roskelly & Jakobson; 1980 survey by Boss Engineering; 1984 survey by C. Wilson; 1985 survey by Boss Engineering; 1992 survey by Boss Engineering; and a 1992 survey by Kostecke.

A search of the county surveyor records and the historical survey records held by C. Garlock did not provide any information about this corner.

A search of the area found no other irons. The Northwest corner of Section 2, T1S, R6E was found 175.22 feet West.

I conclude that this found iron marks the location of the SW corner of Section 35, T1N, R6E.



Mary A. Borkowski, RLA • William C. Henderson • Robert J. Jogow Jr., PE, PS • Robert G. Macomber, PE, PS
John L. Snyder, PE, PS • Allen R. Suggitt, PE • Richard G. Timmons, PE, PS