

**SURVEY &
REMONUMENTATION**

FEB 25 1999

FILED 9-

LAND CORNER RECORDATION CERTIFICATE 1998 OCT 27 P 2: 22
Filing Requirement of Act 74, Mich. P.A. 1970

SECTION

For corners in

Livingston
(County)

Located In:

Corner Code //

NANCY HAVILAND
REGISTER OF DEEDS
LIVINGSTON COUNTY, MI.
48843

- | | | |
|---------------------------------------|-------------------------|------------|
| 1. Public Land Survey | T <u>1N</u> R <u>6E</u> | <u>T-5</u> |
| | T _____ R _____ | _____ |
| | T _____ R _____ | _____ |
| | T _____ R _____ | _____ |
| 2. Property Controlling
in Section | S _____ T _____ R _____ | _____ |
| | S _____ T _____ R _____ | _____ |
| 3. Miscellaneous
Property in Sec. | S _____ T _____ R _____ | _____ |
| | S _____ T _____ R _____ | _____ |

LSC971M

Register of Deeds Stamp & File Number

4. Lot No. _____, Recorded Plat _____
5. Private Claims _____

	A	B	C	D	E	F	G	H	I	J	K	L	M
2	6	5	4	3	2	1							
3													
4	7	8	9	10	11	12							
5													
6	18	17	16	15	14	13							
7													
8	19	20	21	22	23	24							
9													
10	30	29	28	27	26	25							
11													
12	31	32	33	34	35	36							
13													

I, Bryan L. Boss, in a field survey on September 30, 1998, do hereby certify that under requirements of P.A. 74, Michigan P.A. of 1970, the corner points mentioned in lines 1 and 2 above were in conformance with regulations and rules therefore as required in the current manual of survey instructions of the United States Department of the Interior, Bureau of Land Management or by a decree of a Court of Law and/or that the corner points mentioned in lines 3, 4 and 5 above were in conformance with the rules of the Michigan Board of Land Surveyors or by a Decree of a Court of Law; established, re-established, monumented, re-monumented, recovered, found as expressed below:

NOTE: Not more than 4 corners, all in the same town and range, may be recorded on this certificate.

A. Description of original monument and accessories and/or subsequent restoration:

Hickory 5" S 55 E 34 links
White Oak 24" S 85 W 93 links


B. Description of corner evidence found and/or method applied in restoring or reestablishing corner:

Found 1½" iron pipe with ½' capped iron inside
2' West of centerline Rushton and 3' South of centerline Silver Lake road

PA. 345 1990, APPROVED BY LIVINGSTON COUNTY
PEER GROUP ON 9-16-98, CO. REP. JED

C. Description of monument for corner and accessories established to perpetuate locating the position of the corner:

Set 30" by 1½" pipe with 6" breakaway and Brass cap stamped
"Livingston County Remonumentation"
N 12 E 150.10 set Remon N/T Westside power pole
N 88 E 54.91 set Remon N/T Northside 22" Hickory
N 17 E 106.57 set Remon N/T Westside power pole
S 33 W 84.07 set Remon N/T Northwest side 26" Walnut

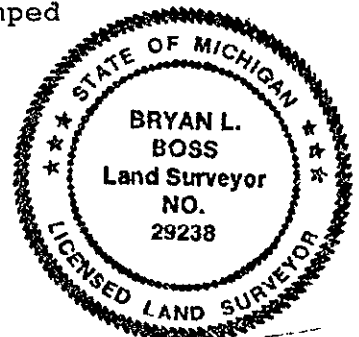

Signed by Bryan L. Boss Date 10-16-1998
Surveyor's Michigan License No. 29238