

SURVEY &
REMONUMENTATION

FEB 25 1999

FILED

SECTION

LAND CORNER RECORDATION CERTIFICATE
Filing Requirement of Act 74, Mich. P.A. 1970

For corners in

Livingston
(County)

Located In:

Corner Code //

1998 OCT 27 P 2:22

NANCY HAVILAND
REGISTER OF DEEDS
LIVINGSTON COUNTY, MI.
48843

LSC972M

Register of Deeds Stamp & File Number

- 1. Public Land Survey T 1N R 6E J-7
 T _____ R _____
 T _____ R _____
 T _____ R _____
- 2. Property Controlling S _____ T _____ R _____
 in Section S _____ T _____ R _____
- 3. Miscellaneous S _____ T _____ R _____
 Property in Sec. S _____ T _____ R _____
- 4. Lot No. _____, Recorded Plat _____
- 5. Private Claims _____

	A	B	C	D	E	F	G	H	I	J	K	L	M
2	6	5	4	3	2	1							
3													
4	7	8	9	10	11	12							
5													
6	18	17	16	15	14	13							
7													
8	19	20	21	22	23	24							
9													
10	30	29	28	27	26	25							
11													
12	31	32	33	34	35	36							
13													

I, Bryan L. Boss, in a field survey on Oct. 7, 1998, do hereby certify that under requirements of P.A. 74, Michigan P.A. of 1970, the corner points mentioned in lines 1 and 2 above were in conformance with regulations and rules therefore as required in the current manual of survey instructions of the United States Department of the Interior, Bureau of Land Management or by a decree of a Court of Law and/or that the corner points mentioned in lines 3, 4 and 5 above were in conformance with the rules of the Michigan Board of Land Surveyors or by a Decree of a Court of Law; established, re-established, monumented, re-monumented, recovered, found as expressed below:

NOTE: Not more than 4 corners, all in the same town and range, may be recorded on this certificate.

A. Description of original monument and accessories and/or subsequent restoration:

set post 1823
White Oak 16" N 5 E 14 L
White Oak 19" S 34 E 1.00 chain


B. Description of corner evidence found and/or method applied in restoring or reestablishing corner:

Found 3/4 pipe with cast iron cap

P.A. 345 1990, APPROVED BY LIVINGSTON COUNTY
PEER GROUP ON 9-2-98 CO. REP JED

C. Description of monument for corner and accessories established to perpetuate locating the position of the corner:

Set 1 1/4' iron pipe 36" long with Brass Cap Stamped "Livingston County Monumentation Corner"
North 9.02 N/T Eastside of power pole
N 70 E 23.90 N/T Southside of 20" White Pine
S 50 E 35.20 N/T Eastside of 46" poplar
N 10 W 54.93 N/T Eastside of 22" White pine

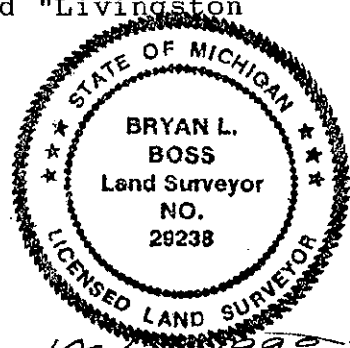

Signed by Bryan L. Boss

Date 10-15-1998

Surveyor's Michigan License No. 29238