

SURVEY & REMONUMENTATION

OCT 26 1995

COMMISSION

LAND CORNER RECORDATION CERTIFICATE
Filing Requirement of Act 74, Mich. P.A. 1970

For corners in Livingston

(County)

Located In:

Corner Code ##

1. Public Land Survey	T	1N	R	6E	J-9
	T		R		
	T		R		
	T		R		
2. Property Controlling in Section	S		T		R
	S		T		R
3. Miscellaneous Property in Sec.	S		T		R
	S		T		R

L. S. C. #463m

Register of Deeds Stamp & File Number

OCT 8 11 58 AM 1995
MARGI HAVILAND
REGISTER OF DEEDS
LIVINGSTON COUNTY MI
48845
FILED

- 4. Lot No. _____, Recorded Plat _____
- 5. Private Claims _____

	A	B	C	D	E	F	G	H	I	J	K	L	M
2	5		5		4		3		2		1		
3													
4	7		8		9		10		11		12		
5													
6	10		17		16		15		14		13		
7													
8	19		20		21		22		23		24		
9													
10	30		29		28		27		26		25		
11													
12	31		32		33		34		35		36		
13													

Bryan Boss, in a field survey on 8-23, 1995, do hereby certify that under requirements of P.A. 74, Michigan P.A. of 1970, the corner points mentioned in lines 1 and 2 above were in conformance with regulations and rules therefore as required in the current manual of survey instructions of the United States Department of the Interior, Bureau of Land Management or by a decree of a Court of Law and/or that the corner points mentioned in lines 3, 4 and 5 above were in conformance with the rules of the Michigan Board of Land Surveyors or by a Decree of a Court of Law; established, re-established, monumented, re-monumented, recovered, found as expressed below:

NOTE: Not more than 4 corners, all in the same town and range, may be recorded on this certificate.

Description of original monument and accessories and/or subsequent restoration:


- White Oak 15" S 11° W 173 links
- White Oak 20" N 4° W 275 links
- Black Oak 13" S 70¼ E 20½

Description of corner evidence found and/or method applied in restoring or reestablishing corner:

- Found 1" iron pipe two feet east of centerline Ruston Road and one foot south of centerline Ten Mile Road
- S 45° E 37.4 - 48" Red Oak
- N 45° W 36.5 - 24" White Oak
- N 45° E 45.4 - utility pole
- S 30° W 77.8 - 40" Red Oak
- West 33.5 - center fence post

Description of monument for corner and accessories established to perpetuate locating the position of the corner:

- Set brass cap on ½" iron in monument box
- 45.96' N 45° E nail & tag south side power pole
- 79.23' S 80° E nail & tag north side power pole
- 71.45' S 15° E nail & tag northeast side power pole
- 46.39' S 45° W nail & tag northwest side power pole

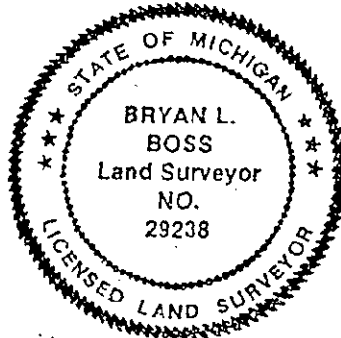

Prepared by Bryan L. Boss Date Oct. 4, 1995
Surveyor's Michigan License No. 29238


SUMMARY
J-9

North 1/4 Corner, Section 26, T1N-R6E, Green Oak Township,
Livingston County, Michigan.

Found 1" inch pipe 2± feet east and 1± foot south of
intersection of Rushton Road and Ten Mile Road three tenths
(.30) below the surface of asphalt. Open field north of
corner with condominiums in SW quadrant and commercial
business in the SE quadrant. Intersection is open for
G.P.S.

Four (4) witnesses set by Grant Dunning in 1927, were still
found by Munsell in 1961 and Charles Wilson in 1972 and they
checked. Found 4 of 5 Darrell Hughes witnesses and they
checked. Distances checked Easterly and Southerly (see page
6 of this dossier).

Conclusion: We find the 1" pipe found on January 13, 1995
to be the same as logged in field notes by Grant H. Dunning
in 1927. Therefore, we recommend it's acceptance.

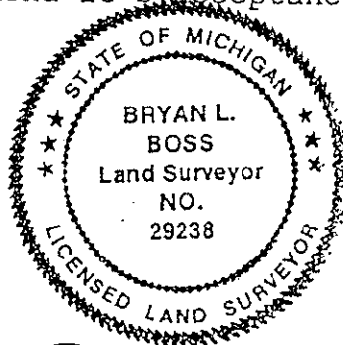

Bryan L. Boss

GOJ-9S