

**LAND CORNER RECORDATION CERTIFICATE**  
**Filing Requirement of Act 74, Mich. P.A. 1970**

NANCY HAVILLAND  
 REGISTER OF DEEDS  
 LIVINGSTON COUNTY, MI  
 48843

Dec 27 11 14 AM '93

FILED

For corners in

<u>Livingston</u> <small>(County)</small>	Located In:	Corner Code #
1. Public Land Survey	T <u>1N</u> R <u>6E</u>	<u>J-11</u>
	T _____ R _____	_____
	T _____ R _____	_____
	T _____ R _____	_____
2. Property Controlling in Section	S _____ T _____ R _____	_____
	S _____ T _____ R _____	_____
3. Miscellaneous Property in Sec.	S _____ T _____ R _____	_____
	S _____ T _____ R _____	_____
4. Lot No. _____, Recorded Plat _____		
5. Private Claims _____		

L.S.C.# 101m

Register of Deeds Stamp & File Number

A	B	C	D	E	F	G	H	I	J	K	L	M
2	6	5	4	3	2	1						
3												
4	7	8	9	10	11	12						
5												
6	18	17	16	15	14	13						
7												
8	19	20	21	22	23	24						
9												
10	30	29	28	27	26	25						
11												
12	31	32	33	34	35	36						
13												

I, H. Lawrence O'Donnell survey on December 21, 1993, do hereby certify that under requirements of P.A. 74, Michigan P.A. of 1970, the corner points mentioned in lines 1 and 2 above were in conformance with regulations and rules therefor as required in the current manual of survey instructions of the United States Department of the Interior, Bureau of Land Management or by a decree of a Court of Law and/or that the corner points mentioned in lines 3, 4 and 5 above were in conformance with the rules of the Michigan Board of Land Surveyors or by a Decree of a Court of Law, established, re-established, monumented, re-monumented, recovered, found as expressed below:

**NOTE: Not more than 4 corners, all in the same town and range, may be recorded on this certificate.**

A. Description of original monument and accessories and/or subsequent restoration:


GLO survey 1816 by Joseph Wampler  
 set qr. post  
 W. Oak 24 N12-1/2 E 42 lks  
 B. Oak 13 S41W 16 lks  
 (Additional historical data on back of sheet)

B. Description of corner evidence found and/or method applied in restoring or reestablishing corner:

Found 1/2" iron pipe  
 LCS #197 by N. Fahrner in March 1972  
 references witnesses as established by Atwell-Hicks in 1957.

C. Description of monument for corner and accessories established to perpetuate locating the position of the corner:

Set 1-1/4"x42" breakaway iron pipe with brass cap in monument box.  
 Utility pole N45°E 44.40' to nail w/flasher  
 " " S50°E 47.74' to nail w/flasher  
 " " S50°W 41.59' to nail w/flasher  
 " " S20°W 92.58' to nail w/flasher

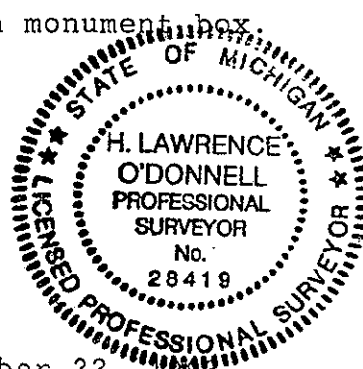

SURVEYOR  
 REMONUMENTATION

1993

COMMISSION

Signed by H. Lawrence O'Donnell Date December 22, 1993

Surveyor's Michigan License No. 28419  
 Approved by Livingston County Monumentation Peer Group  
 November 10, 1993

Civil Engineering • Surveying  
Planning • Environmental Services

# A T W E L L - H I C K S , I N C .

540 Avis Drive  
P.O. Box 2981  
Ann Arbor, Michigan 48106  
313 994 4000 • FAX: 313 994 1599

## RESEARCH SUMMARY

J-11, N 1/4 Corner Section 35, T1N, R6E

Found 1/2" iron pipe at the location of the N 1/4 Corner, Section 35, T1N, R6E in the intersection of Nine Mile Rd. and Rushton Rd.

Original GLO survey notes reference set gr. set post at 41.03 ch from which:  
a W. Oak 24 in dia bears N12-1/2E 42 lks  
a B Oak 13 in dia bears S41W 16 lks

Earliest found reference to the Corner was a February/March 1957 survey by Atwell-Hicks, Inc.

Corner is referenced in a 1972 survey & PA 74 by Washtenaw Engineering; 1972 Survey by Finney & Kostecke; 1973 Survey by Finney & Kostecke; 1976 Survey by Washtenaw Engineering; 1979 Survey by Boss Engineering; 1979 Survey by R. Donnelly.

A search of the county surveyor records and the historical survey records held by C. Garlock, RLS did not provide any information on this corner.

A search of the area found no other irons. I conclude that this iron pipe marks the location of the N 1/4 corner of Section 35, T1N, R6E.



Mary A. Borkowski, RLA • William C. Henderson • Robert J. Jagow Jr., PE, PS • Robert G. Macomber, PE, PS  
John L. Snyder, PE, PS • Allen R. Suggitt, PE • Richard G. Timmons, PE, PS