

LAND CORNER RECORDATION CERTIFICATE
Filing Requirement of Act 74, Mich. P.A. 1970

DEC 27 11 24 AM '93
 NANCY HAYLAND
 REGISTER OF DEEDS
 LIVINGSTON COUNTY, MI
 48843

FILED

For corners in

<u>Livingston</u> <small>(County)</small>	Located In:	Corner Code #
1. Public Land Survey	T <u>1N</u> R <u>6E</u>	<u>K-13</u>
	T _____ R _____	_____
	T _____ R _____	_____
	T _____ R _____	_____
2. Property Controlling in Section	S _____ T _____ R _____	_____
	S _____ T _____ R _____	_____
3. Miscellaneous Property in Sec.	S _____ T _____ R _____	_____
	S _____ T _____ R _____	_____

L.S.C. # 105m

Register of Deeds Stamp & File Number

4. Lot No. _____, Recorded Plat _____
 5. Private Claims _____

	A	B	C	D	E	F	G	H	I	J	K	L	M
2	6	5	4	3	2	1							
3													
4	7	8	9	10	11	12							
5													
6	18	17	16	15	14	13							
7													
8	19	20	21	22	23	24							
9													
10	30	29	28	27	26	25							
11													
12	31	32	33	34	35	36							
13													

I, H. Lawrence O'Donnell survey on December 17, 1993, do hereby certify that under requirements of P.A. 74, Michigan P.A. of 1970, the corner points mentioned in lines 1 and 2 above were in conformance with regulations and rules therefore as required in the current manual of survey instructions of the United States Department of the Interior, Bureau of Land Management or by a decree of a Court of Law and/or that the corner points mentioned in lines 3, 4 and 5 above were in conformance with the rules of the Michigan Board of Land Surveyors or by a Decree of a Court of Law; established, re-established, monumented, re-monumented, recovered, found as expressed below:

NOTE: Not more than 4 corners, all in the same town and range, may be recorded on this certificate.

A. Description of original monument and accessories and/or subsequent restoration:

GLO survey November 1815 by Joseph Wampler
 set post cor. to sec's 35 & 36
 W. Oak 24 S33W 29 lks.
 W. Oak 12 N24E 8 lks.
 (Additional historical data on back of sheet)


COMMISSION
 RECORDATION
 1993
 COMMISSION

B. Description of corner evidence found and/or method applied in restoring or reestablishing corner:

Found 3/4" iron pipe as referenced in March 1957 survey by Atwell-Hicks and LCS #1332 by H. Munzel in 1983.

C. Description of monument for corner and accessories established to perpetuate locating the position of the corner:

Set 1-1/4" x 42" breakway iron pipe with brass cap
6" below grade
 16" Hickory N15°E 28.72' to nail w/flasher
 10" Hickory South 21.13' to nail w/flasher
 9" Hickory S30°E 29.46' to nail w/flasher
 14" Hickory S20°W 28.87' to nail w/flasher

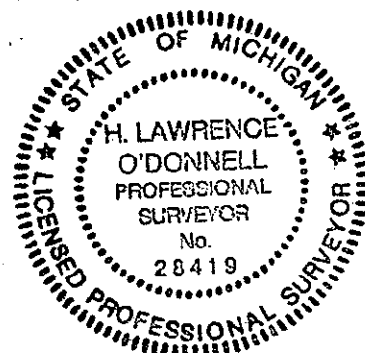

Signed by H. Lawrence O'Donnell Date December 20, 1993
 Surveyor's Michigan License No. 28419

Civil Engineering • Surveying
Planning • Environmental Services

A T W E L L - H I C K S , I N C .

540 Avis Drive
P.O. Box 2981
Ann Arbor, Michigan 48106
313 994 4000 • FAX: 313 994 1599

RESEARCH SUMMARY

K-13 SW Corner Section 36, T1N, R6E

Found 3/4" Iron pipe at the SW corner location.

Corner referenced in 1957 survey by Atwell-Hicks, Inc.; 1972 survey by Atwell-Hicks, Inc.; 1980 survey by W.E. Co.; 1983 PA 74 by H. Munzel.

A search of the area found no other irons. An iron marking the NW Corner Section 1, T1S, R6E was found 267.44 feet West.

I conclude that the iron found marks the SW Corner Section 36, T1N, R6E.



Mary A. Borkowski, RLA • William C. Henderson • Robert J. Jagow Jr., PE, PS • Robert G. Macomber, PE, PS
John L. Snyder, PE, PS • Allen R. Suggitt, PE • Richard G. Timmons, PE, PS